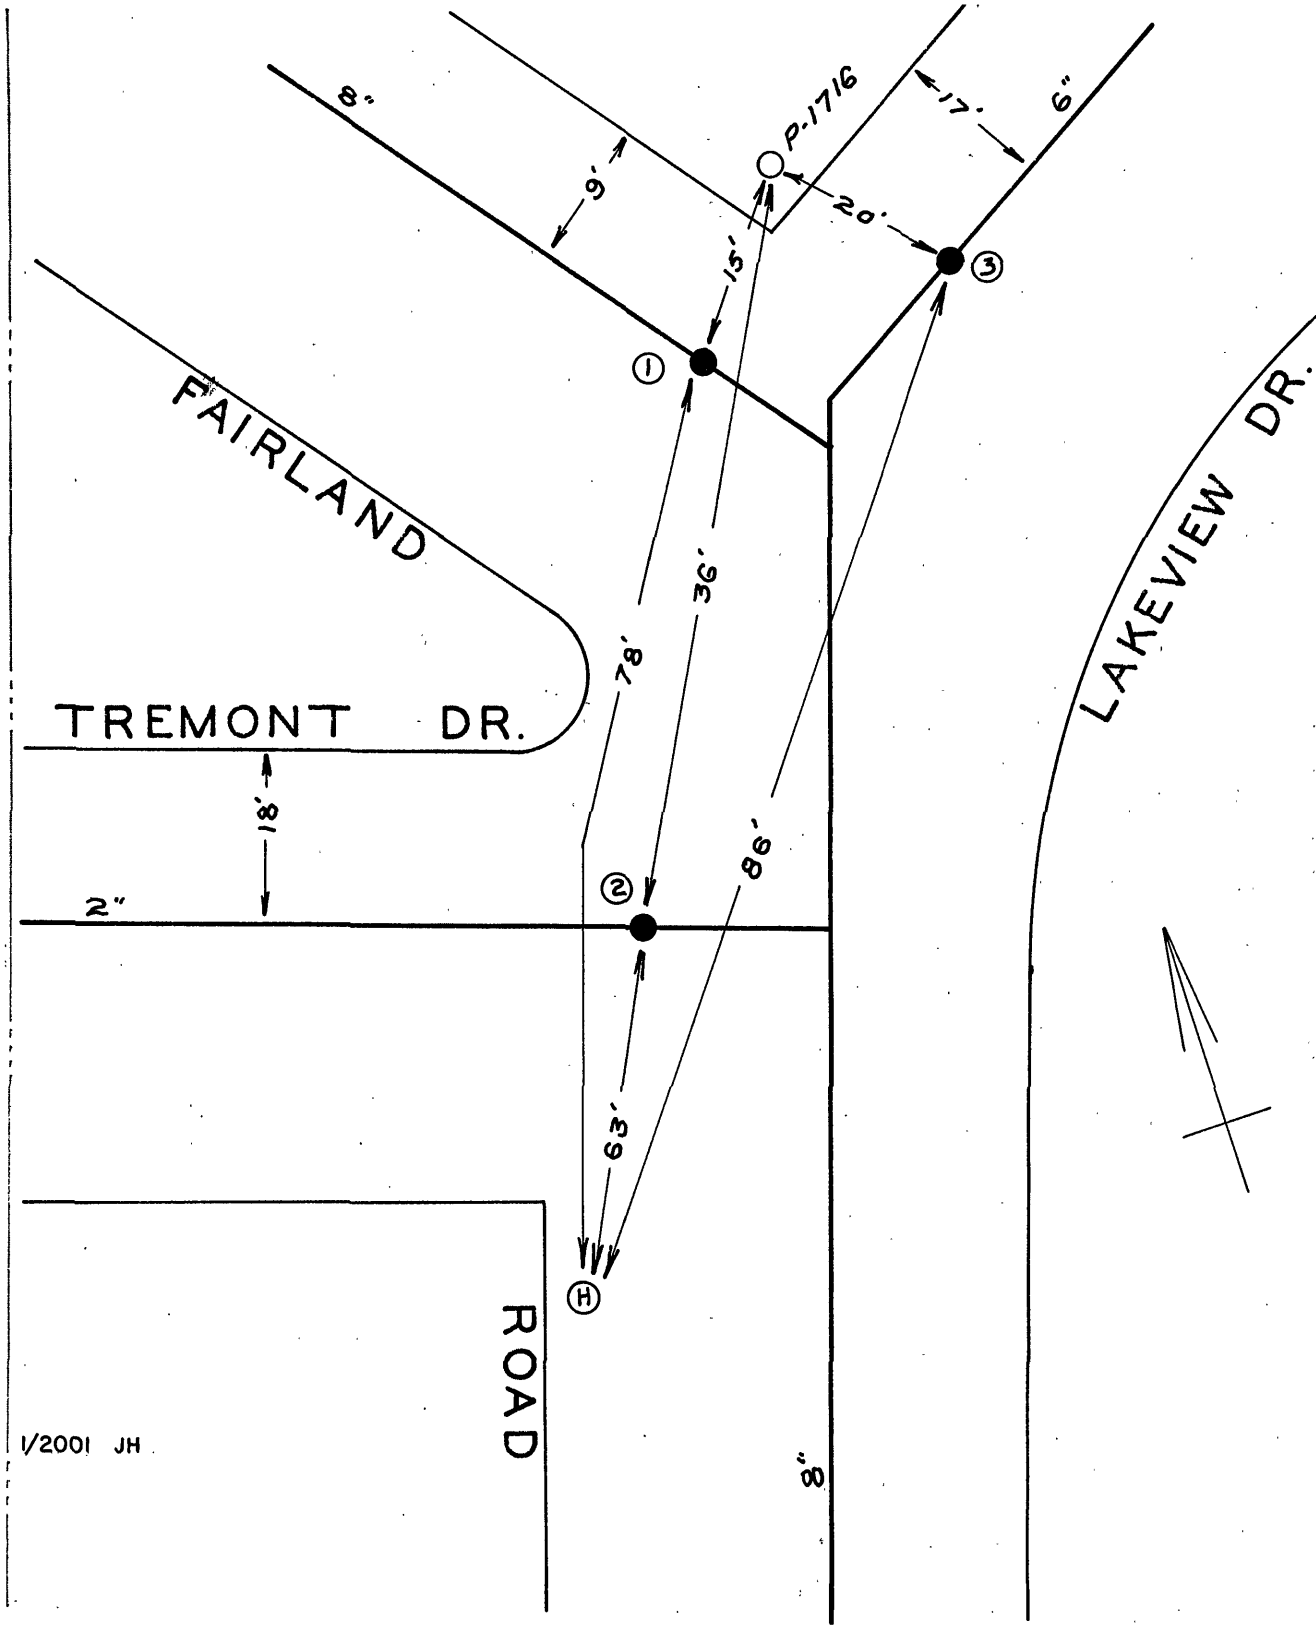

DATE	NO.	SIZE	MAKE	OPEN	TURNS
1950	1	8"	DARLING	R	27
1950	2	2"	DARLING	R	7
1950	3	6"	DARLING	R	20
	1	13'-S	NPL		
	2	10'-E	WPL		
	3	11'-E	EPL		

CITY OF ROANOKE—WATER DEPT.

VALVE DIAGRAM

FAIRLAND RD.-LAKEVIEW DR. & TREMONT DR. N. W.

SEC. MAP 247

DATE PAGE NO.

1/2001 JH

"IMPERIAL" TRACING CLOTH. K & E CO., N. Y.