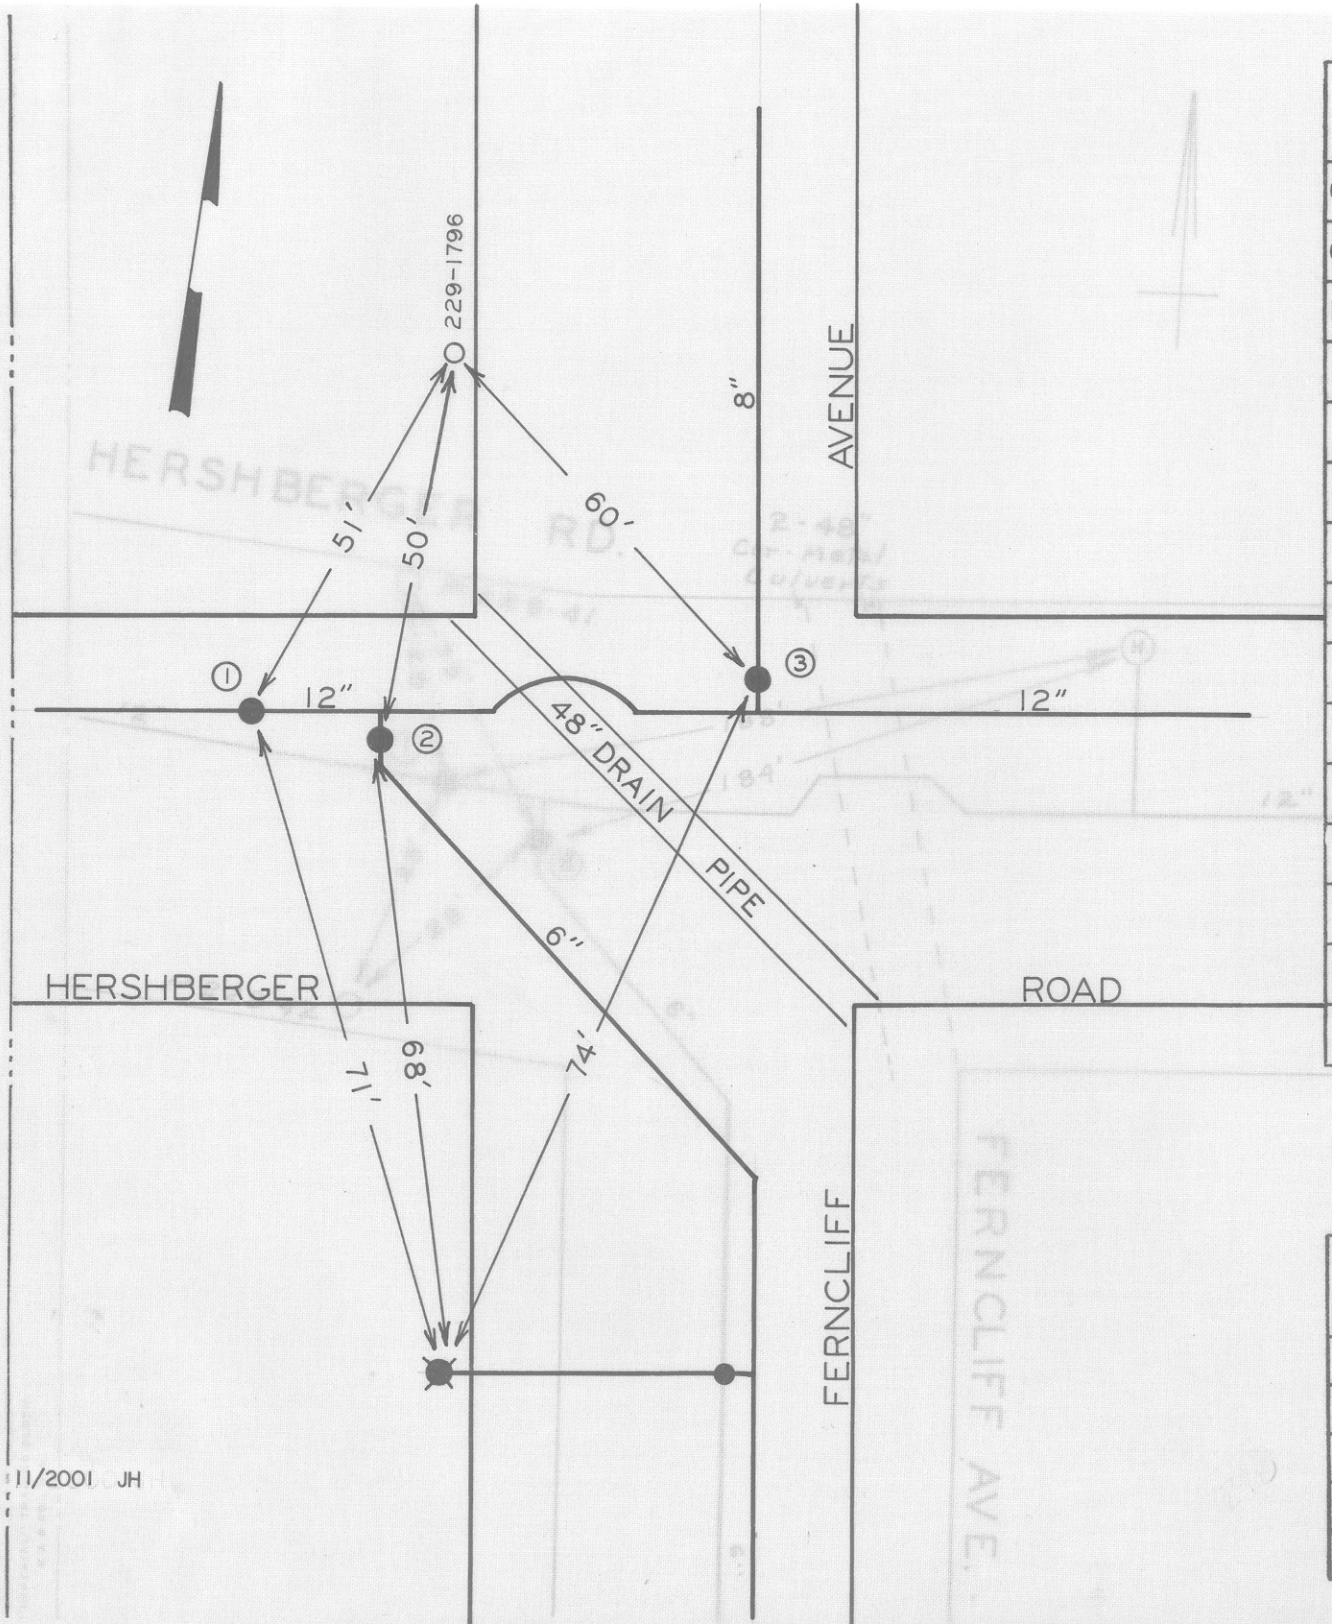

DATE	NO.	SIZE	MAKE	OPEN	TURNS
6-55	1	12"	MUELLER	R	38
6-55	2	6"	DARLING	R	21
11-68	3	8"	MUELLER	R	27
	1	17'W	WPL		
	2	14'W	WPL		
	3	27'S	NPL		

CITY OF ROANOKE—WATER DEPT.

VALVE DIAGRAM

FERNCLIFF AVE. &

HERSHBERGER RD.

SEC. MAP 248 N.W.

DATE PAGE NO.