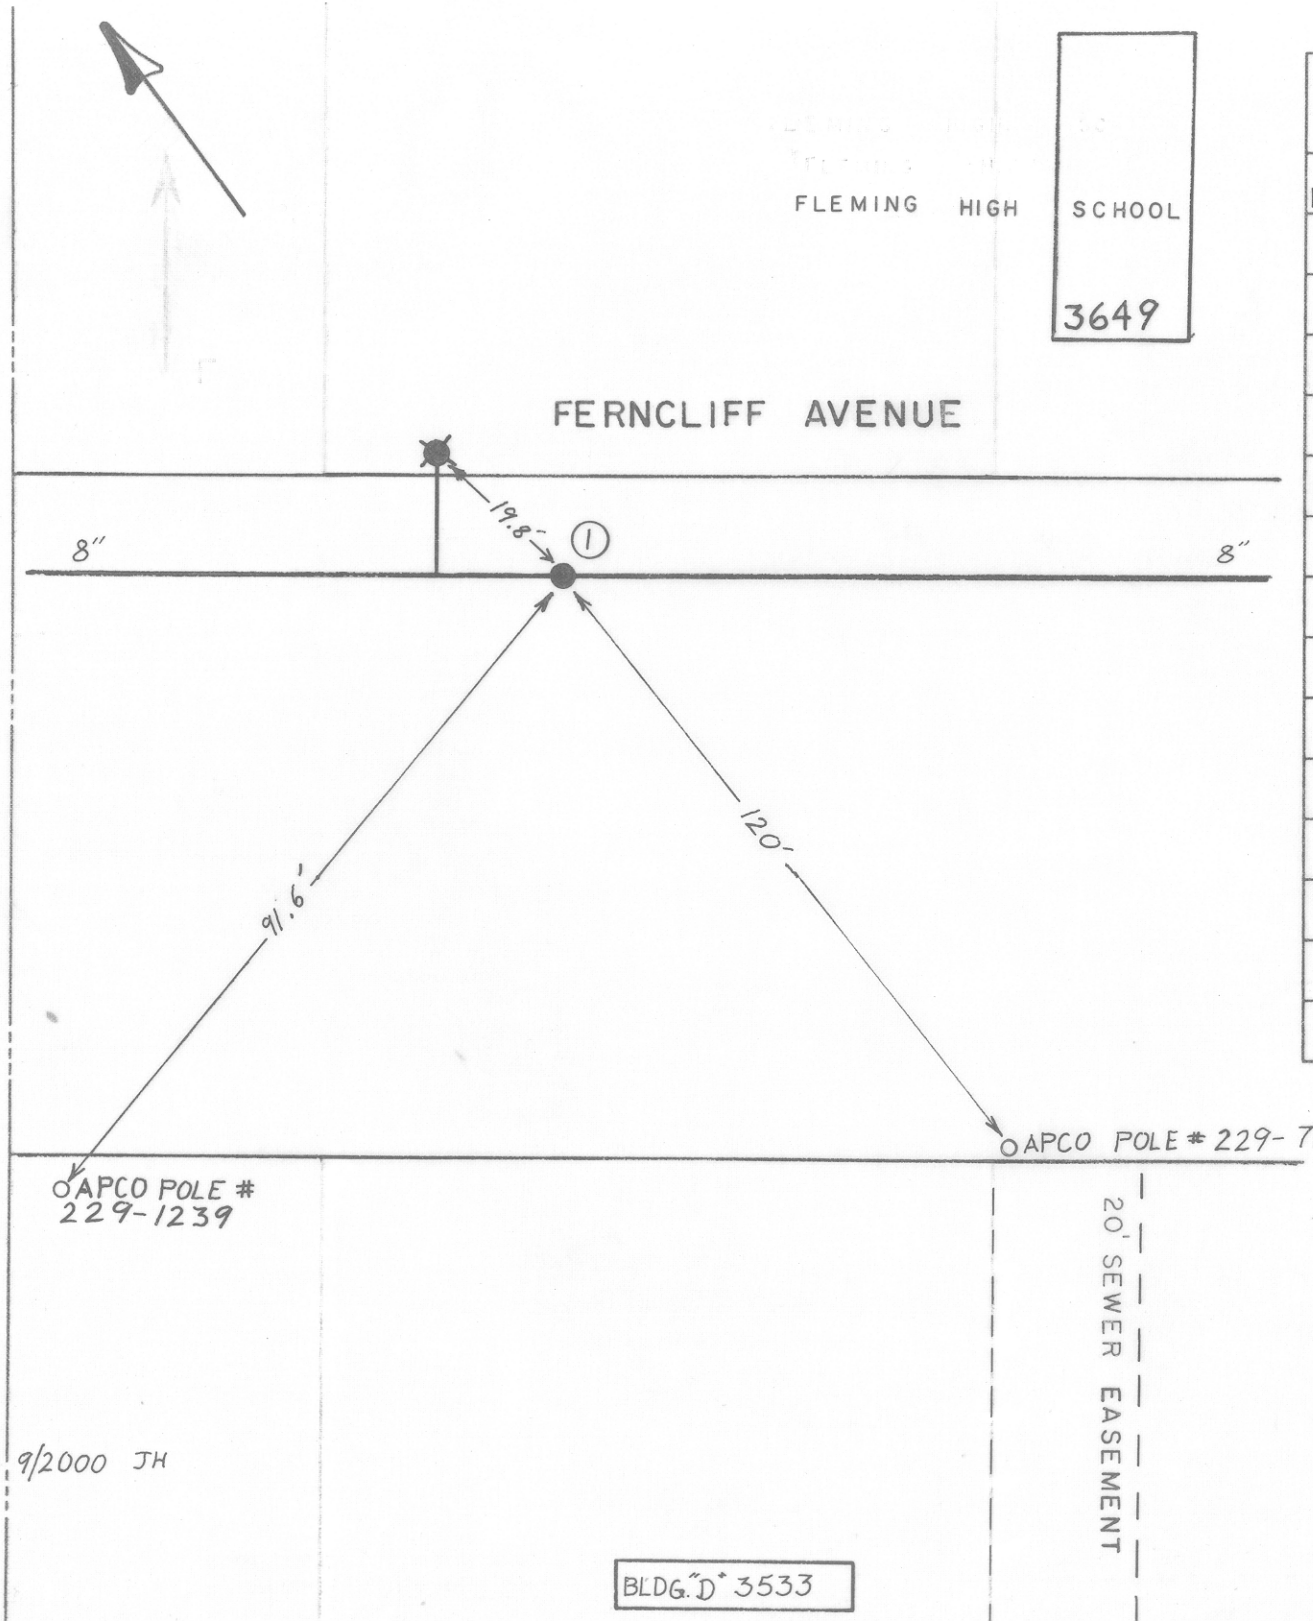

DATE	NO.	SIZE	MAKE	OPEN	TURNS
1987	1	8"		R	20

CITY OF ROANOKE—WATER DEP'T

VALVE DIAGRAM

FERNCLIFF AVENUE

500' SOUTHEAST OF

ROUTT ROAD

SEC. MAP 644, 646 N.W.

DATE PAGE NO.