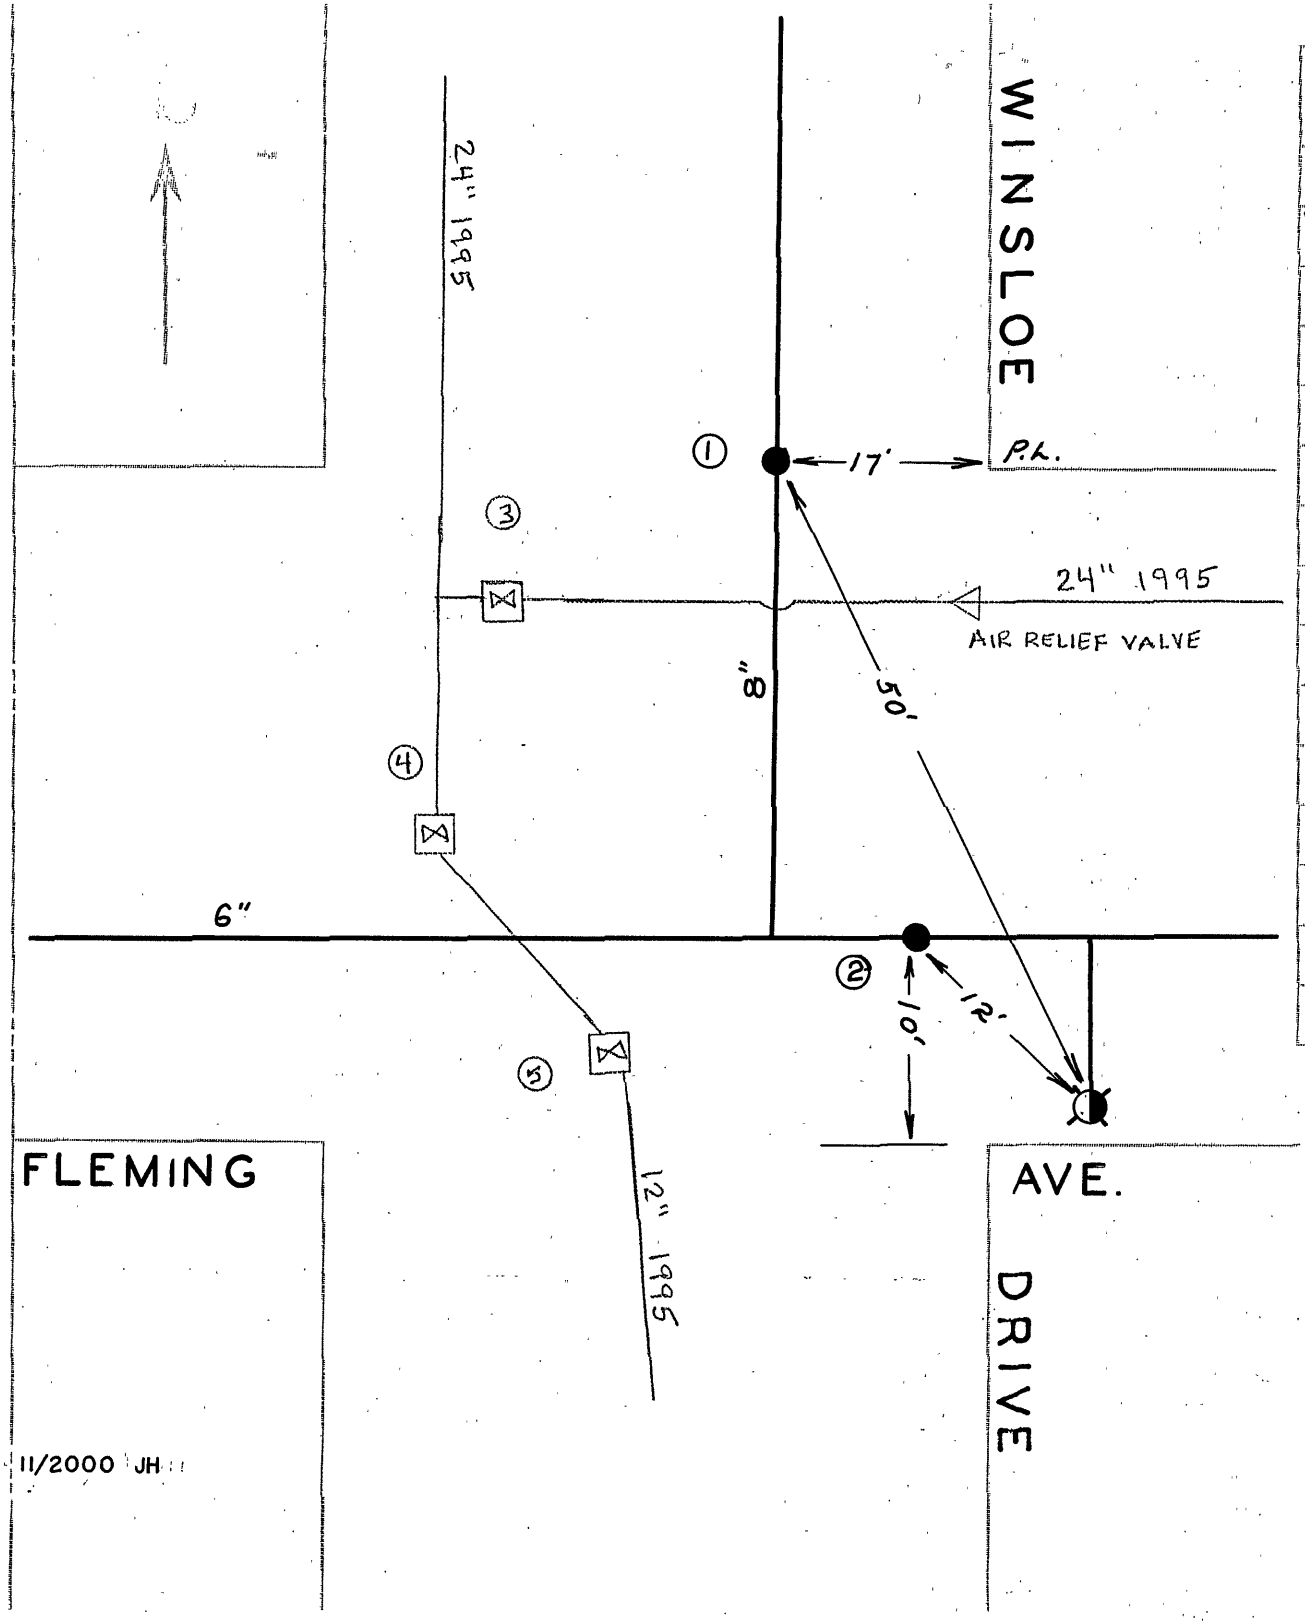

DATE	NO.	SIZE	MAKE	OPEN	TURNS
1955	1	8"	MUELLER	R	27
W.R. 1951	2	6"	MUELLER	R	21
1995	3	24"	BUTTERFLY		
1995	4	24"	BUTTERFLY		
1995	4	24"	BUTTERFLY		
	1	0	NPL		
	2	4'-W	EPL		

CITY OF ROANOKE—WATER DEP'T

VALVE DIAGRAM

FLEMING AVE. &

WINSLOE DR.

SEC. MAP 209 N. W.

DATE PAGE NO.

11/2000 JH