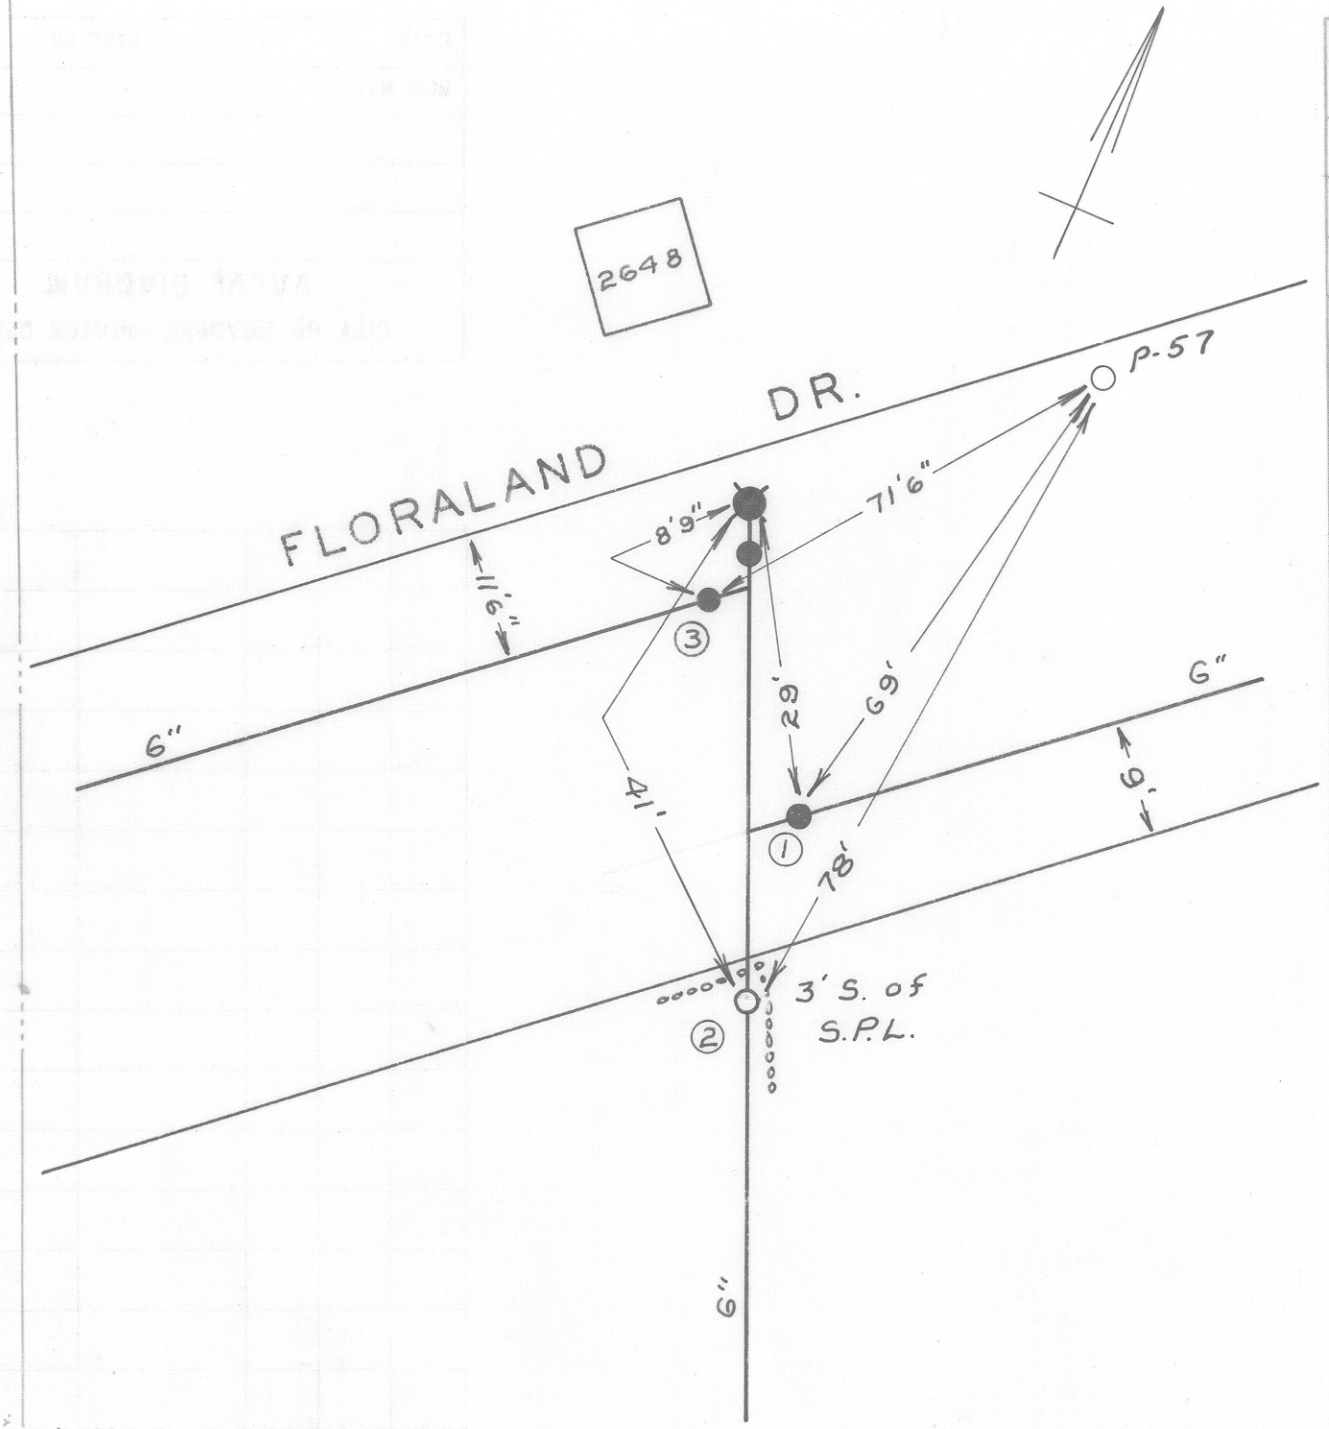


| DATE | NO. | SIZE | MAKE | OPEN | TURNS |
|---|---|---|---|---|---|
| W. R. 1951 | 1 | 6" | | R | |
| W. R. 1951 | 2 | 6" | | R | |
| 1953 | 3 | 6" | | R | |
| | | | | | |
| | | | | | |
| | | | | | |
| | | | | | |
| | | | | | |
| | | | | | |
| | | | | | |
| | | | | | |
| | | | | | |
| | 1 | 454'-W WPL | | EDEN | |
| | 2 | 457'-W WPL | | DRIVE | |
| | | | | | |

CITY OF ROANOKE—WATER DEPT.

VALVE DIAGRAM

FLORALAND DR. 454'-W

OF EDEN DR. N. W. AT

HOUSE NO. 2648

SEC. MAP 226 N.W

DATE PAGE NO.

11/2000 JH

"IMPERIAL" TRACING CLOTH K & E CO., N. Y.