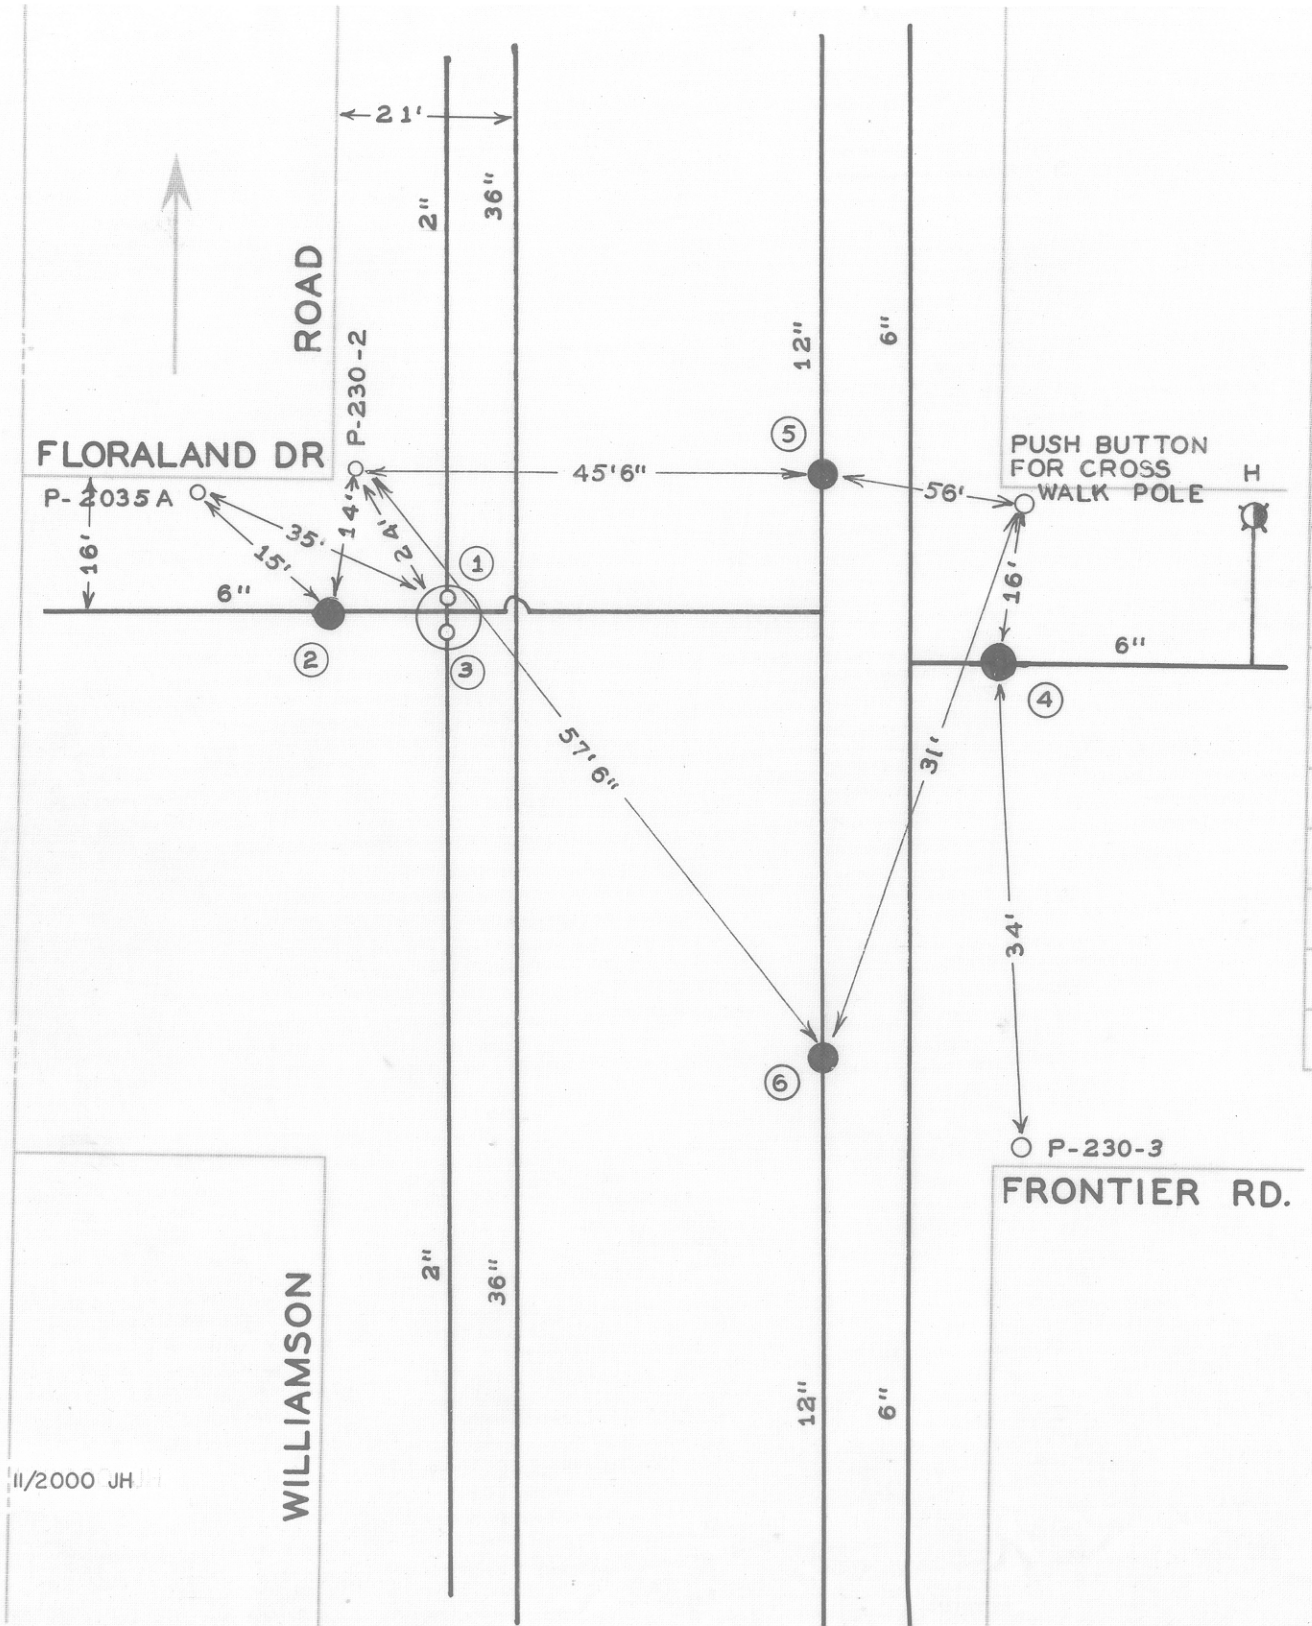

DATE	NO.	SIZE	MAKE	OPEN	TURNS
W.R.	1	2"	DARLING	R	7
'53	2	6"	MUELLER	R	20
W.R.	3	2"	DARLING	R	7
W.R.	4	6"	DARLING	R	
'52	5	12"	MUELLER	R	38
'52	6	12"	MUELLER	R	38
	1	16'S	N.P.L		
	2	0	W.P.L.		
	3	16'S	N.P.L.		
	4	0	EPL		
	5	0	NPL		
	6	13'N.	SPL		

CITY OF ROANOKE—WATER DEP'T

VALVE DIAGRAM

FLORALAND DR., FRONTIER RD. & WILLIAMSON ROAD

N.W.

SEC. MAP 217 N.W.

DATE PAGE NO.