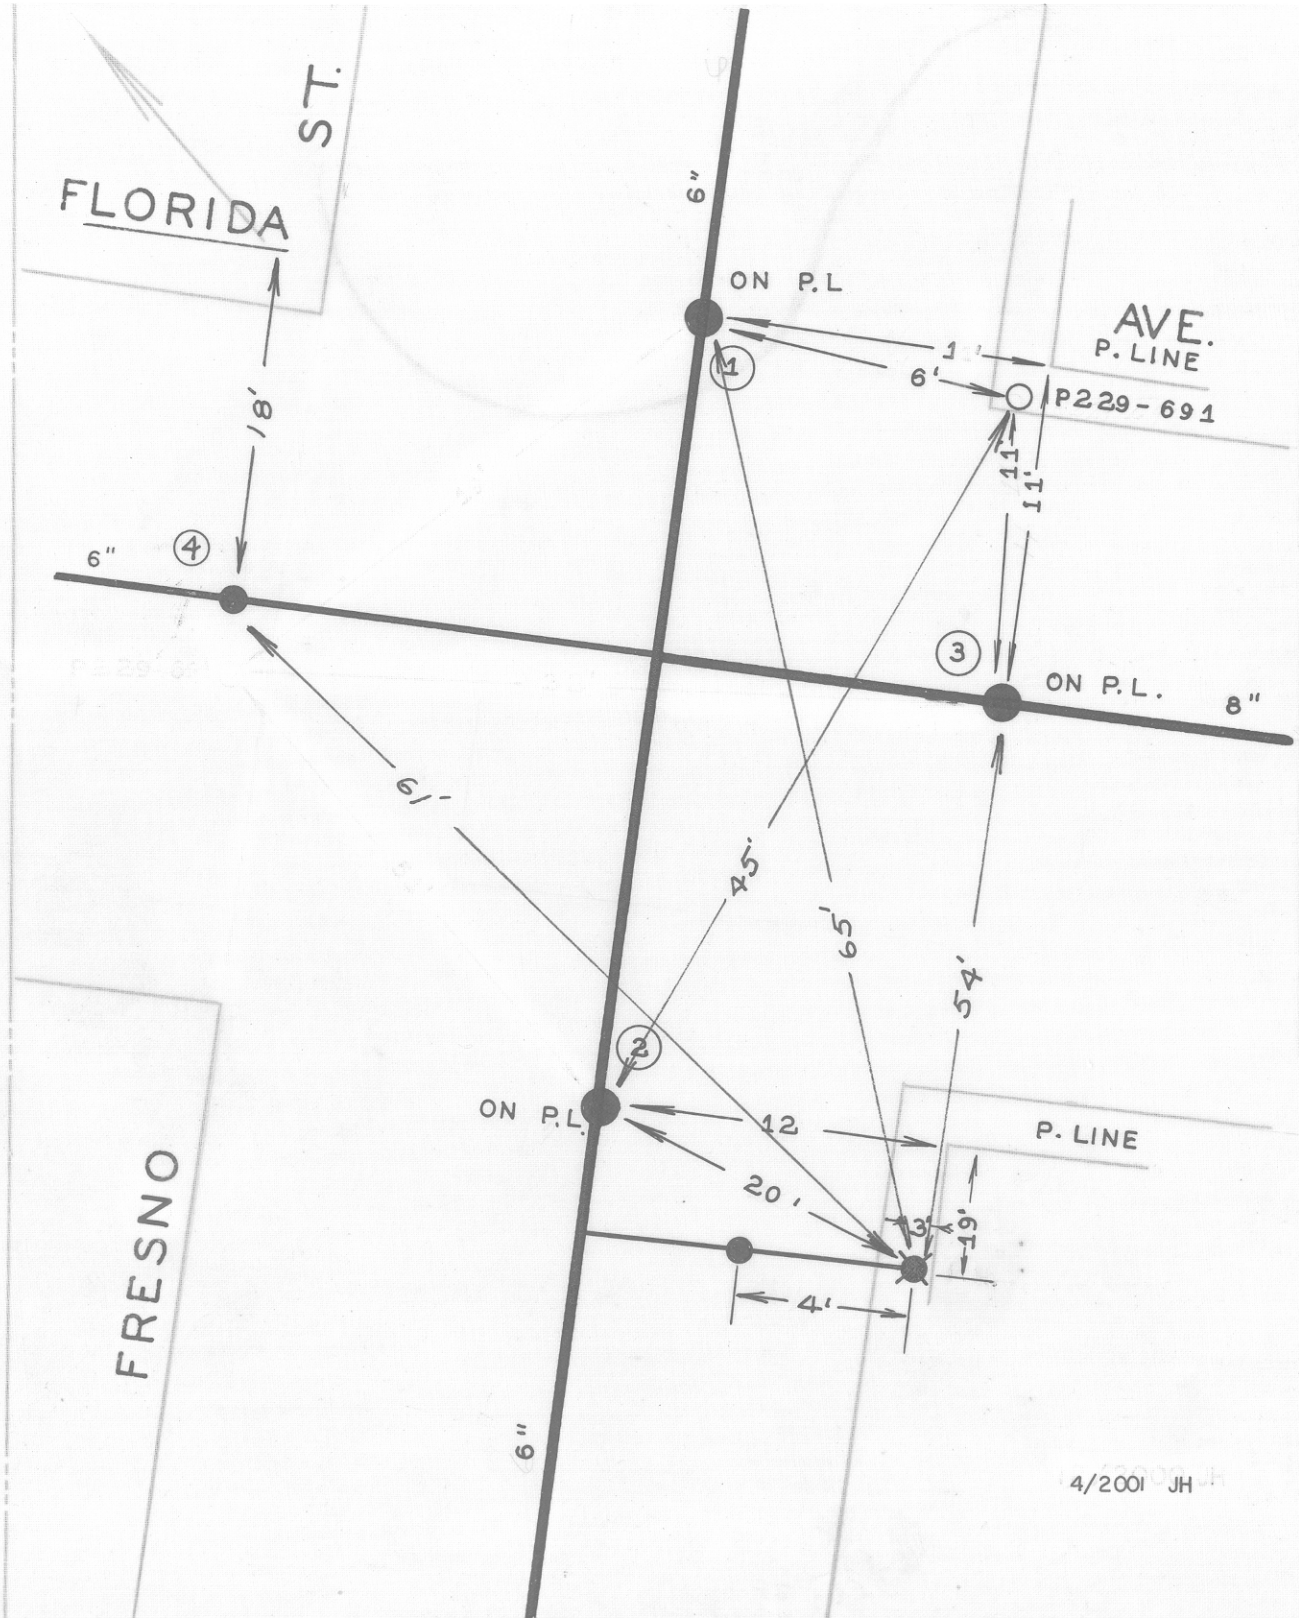

DATE	NO.	SIZE	MAKE	OPEN	TURNS
1949	1	6"	DARLING	R	20 1/2
1949	2	6"	DARLING	R	21
1949	3	8"	DARLING	R	27
1955	4	6"	MUELLER	R	21
	1	0	NPL		
	2	0	SPL		
	3	0	EPL		
	4	0	WPL		

CITY OF ROANOKE—WATER DEP'T

VALVE DIAGRAM

FLORIDA AVENUE & FRESNO STREET

SEC. MAP 246 N.W.

DATE PAGE NO. N.W.339