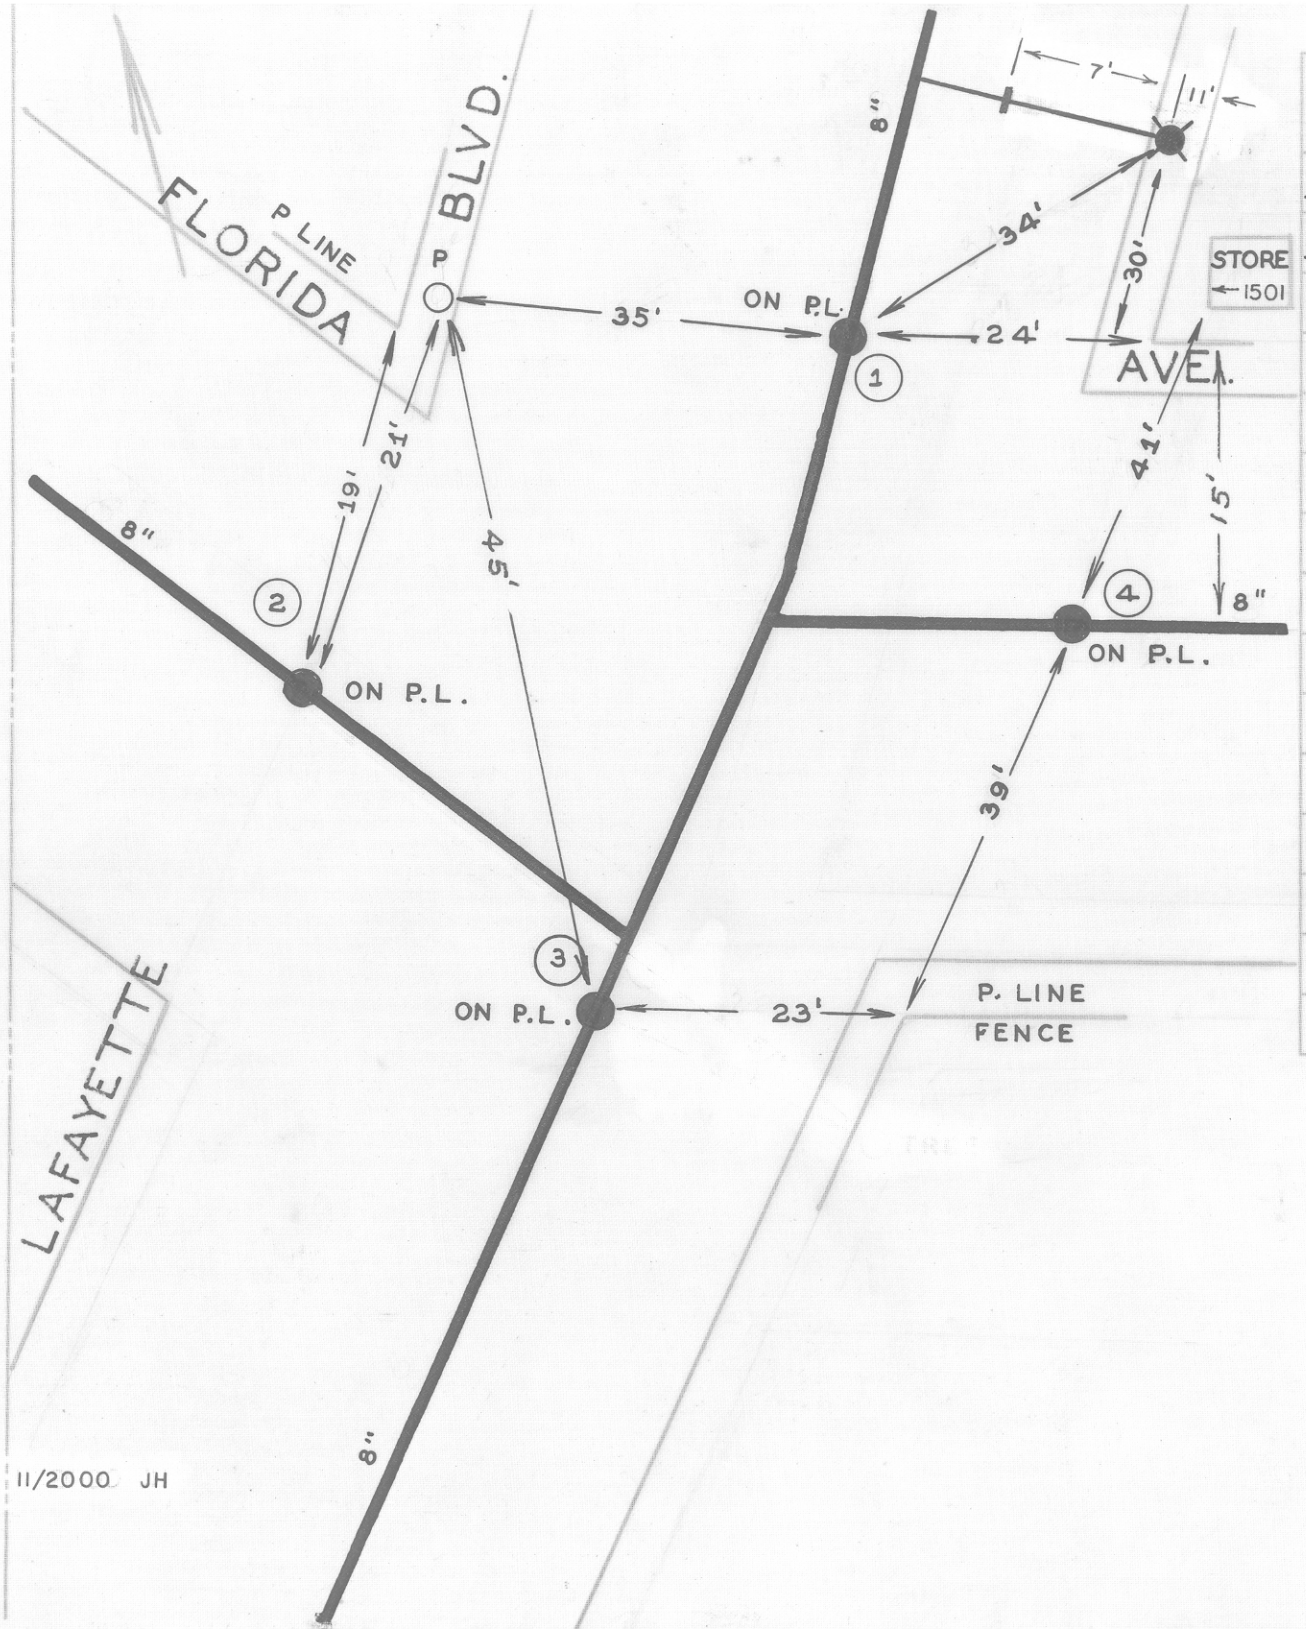


| DATE | NO. | SIZE | MAKE | OPEN | TURNS |
|---|---|---|---|---|---|
| 1949 | 1 | 8 | DARLING | R | 27 |
| 1949 | 2 | 8 | DARLING | R | 27 |
| 1949 | 3 | 8 | DARLING | R | 26 1/2 |
| 1949 | 4 | 8 | DARLING | R | 27 |
| | | | | | |
| | | | | | |
| | | | | | |
| | | | | | |
| | | | | | |
| | | | | | |
| | | | | | |
| | 1 | 0 | NPL | | |
| | 2 | 0 | WPL | | |
| | 3 | 0 | SPL | | |
| | 4 | 0 | EPL | | |

CITY OF ROANOKE—WATER DEP'T

VALVE DIAGRAM

FLORIDA AVENUE &

LAFAYETTE BOULEVARD

SEC. MAP 245 N.W.

DATE PAGE NO. N.W. 265