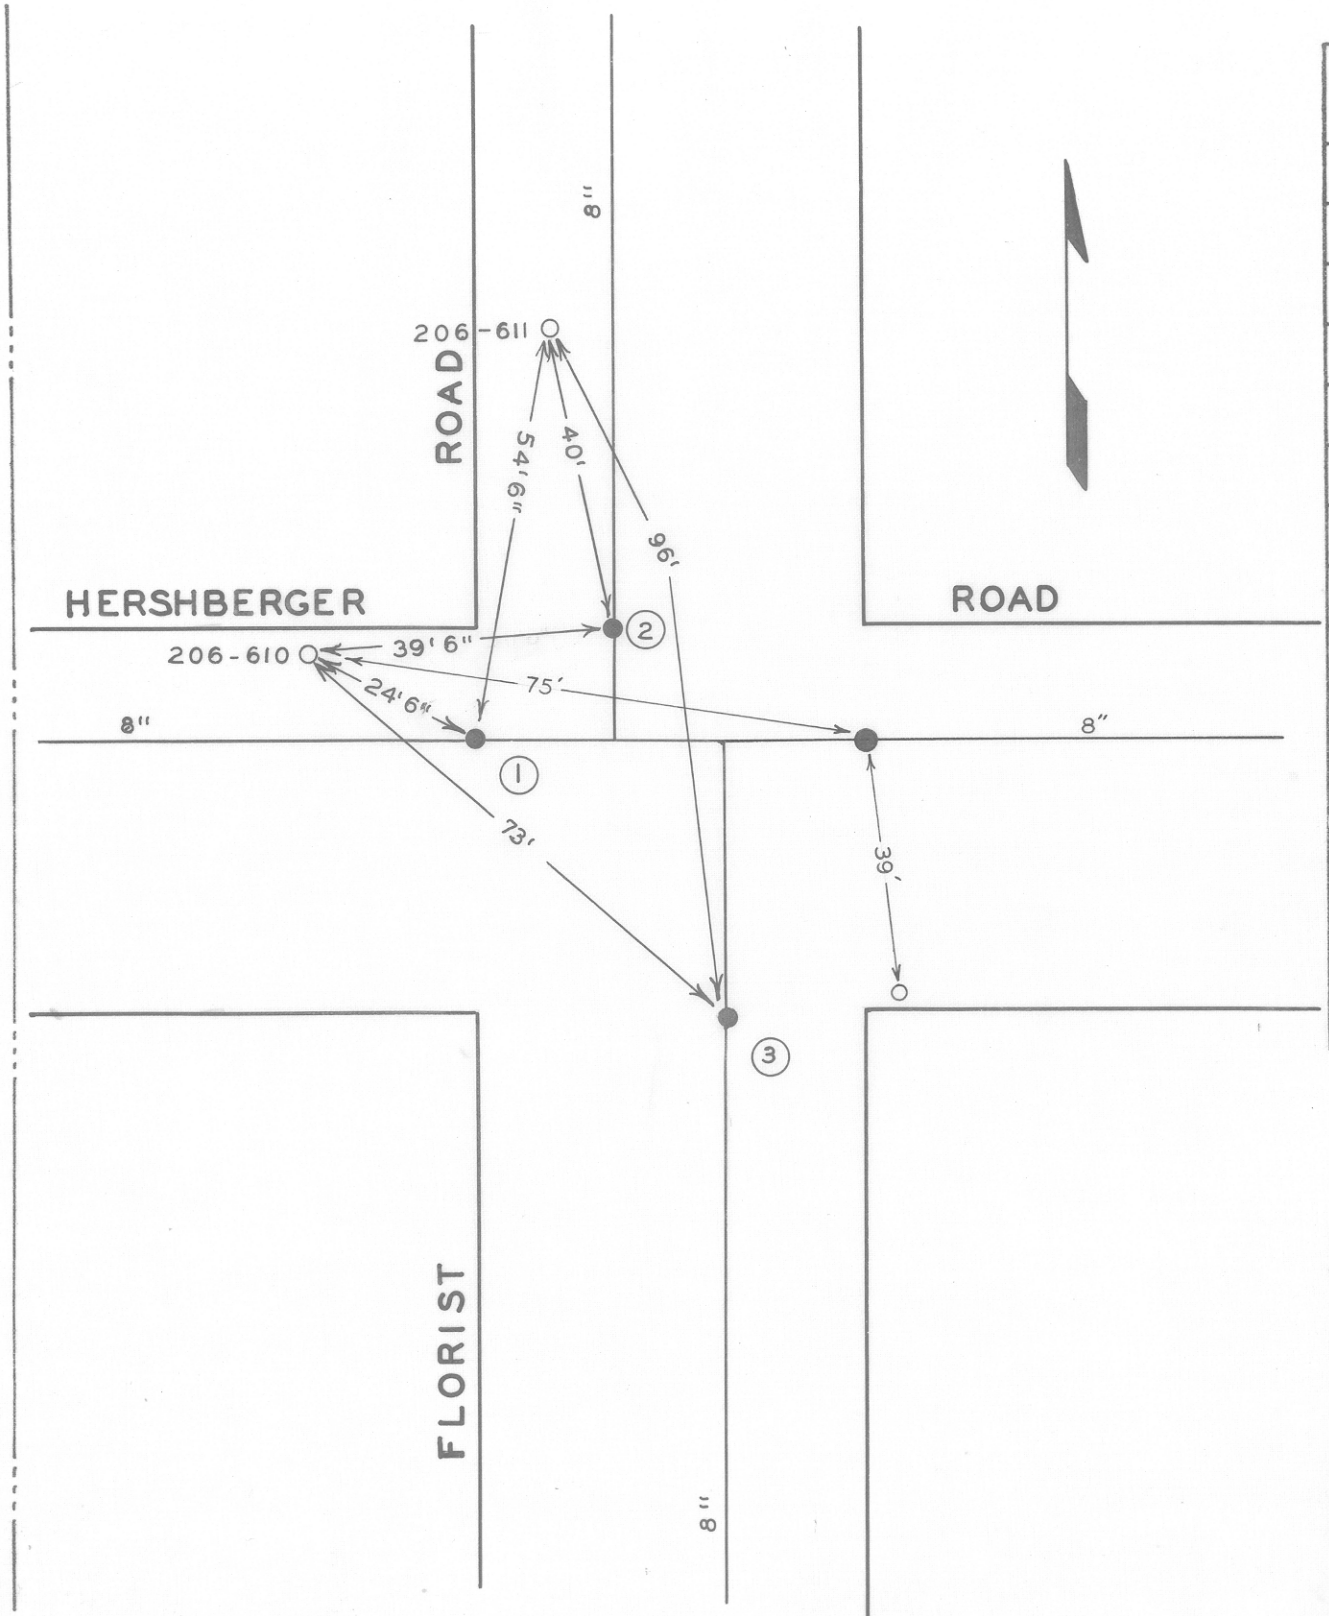

DATE	NO.	SIZE	MAKE	OPEN	TURNS
1957	1	8"	MUELLER	R	
1957	2	8"	MUELLER	R	
8-63	3	8"	MUELLER	R	
7-73	4	8"	MUELLER	R	
	1	0	W.P.L.		
	2	0	N.P.L.		

CITY OF ROANOKE—WATER DEPT.

VALVE DIAGRAM

FLORIST ROAD &

HERSHBERGER ROAD N.W.

SEC. MAP 220

DATE PAGE NO.