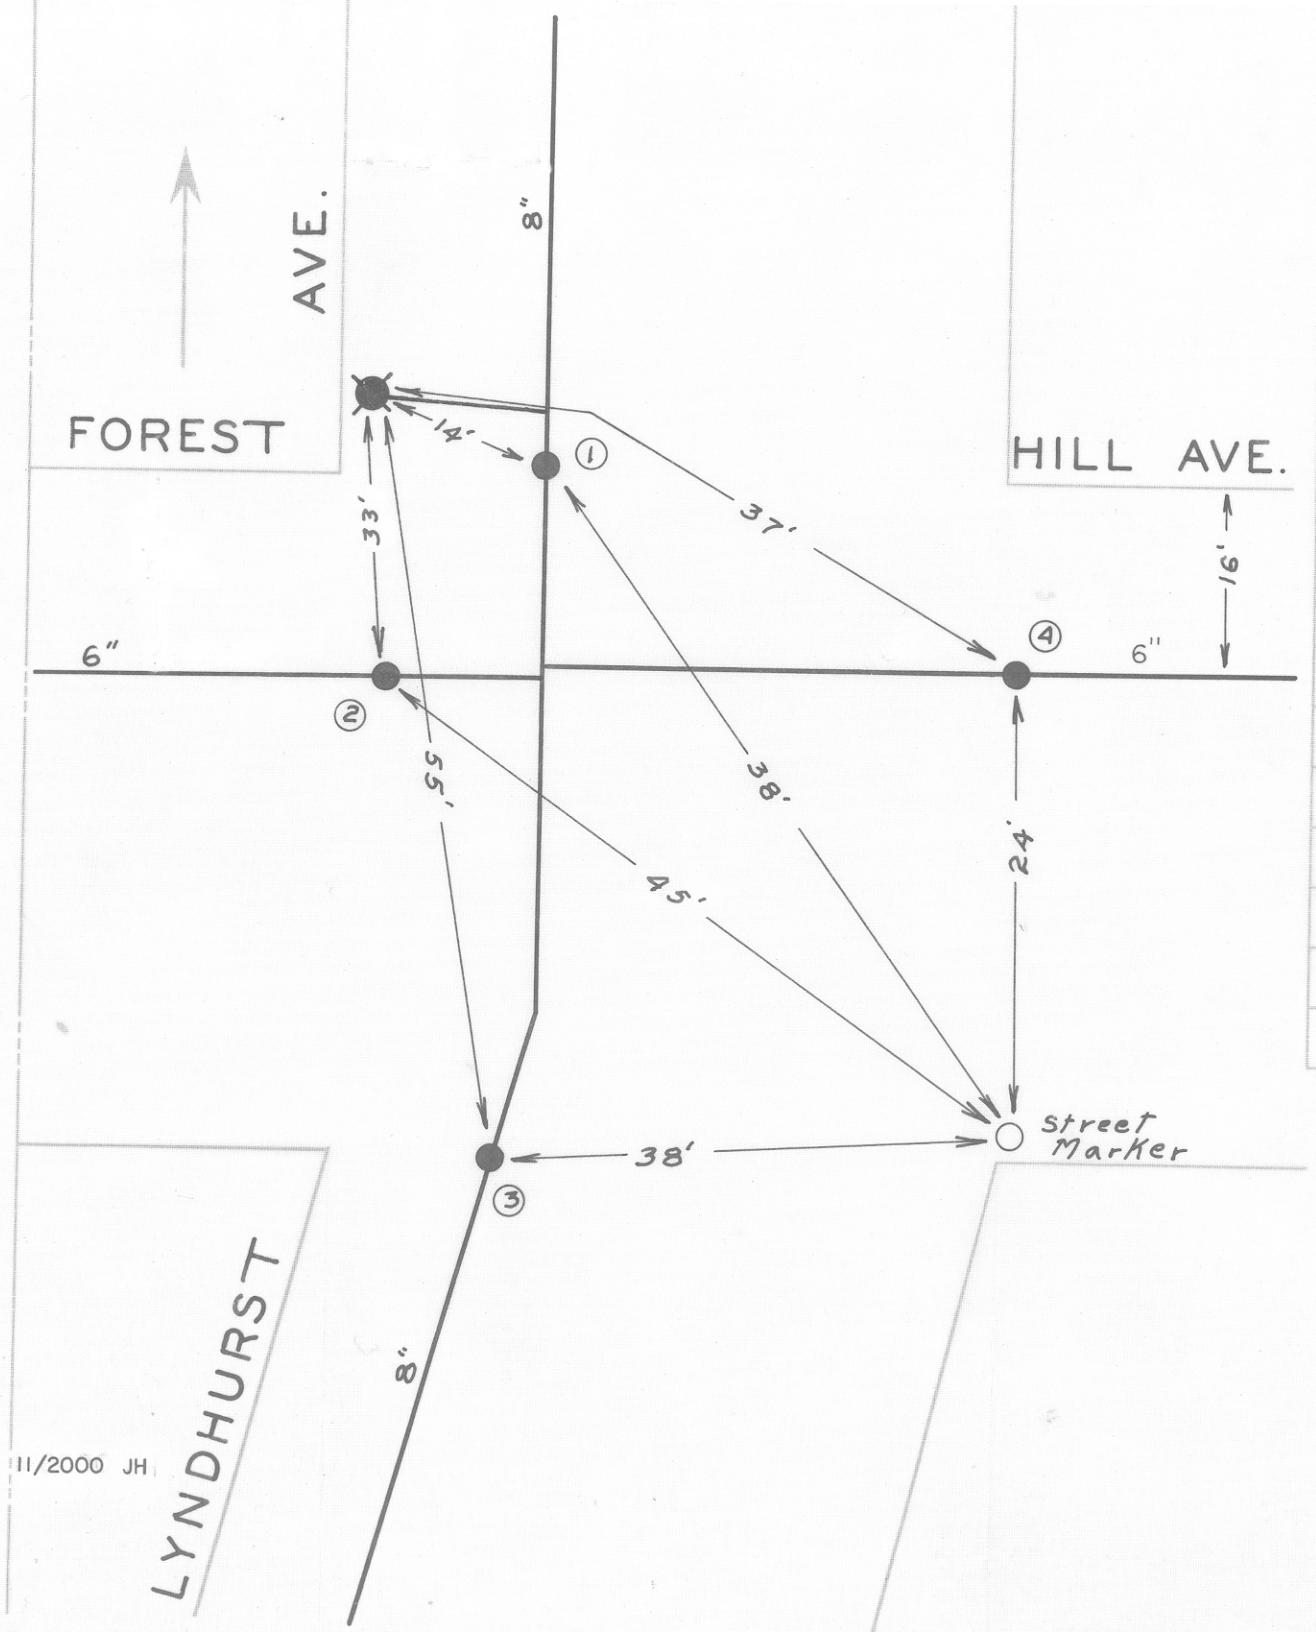

DATE	NO.	SIZE	MAKE	OPEN	TURNS
1953	1	8"		R	26
57	2	6"	MUELLER	R	
1953	3	8"		R	26
1954	4	6"		R	20
	1	0	NPL		
	2	0	WPL		
	3	0	SPL		
	4	0	EPL		

CITY OF ROANOKE—WATER DEP'T

VALVE DIAGRAM

FOREST HILL AVE. &
LYNDHURST ST.

SEC. MAP 207,206 N.W.

DATE PAGE NO.

11/2000 JH