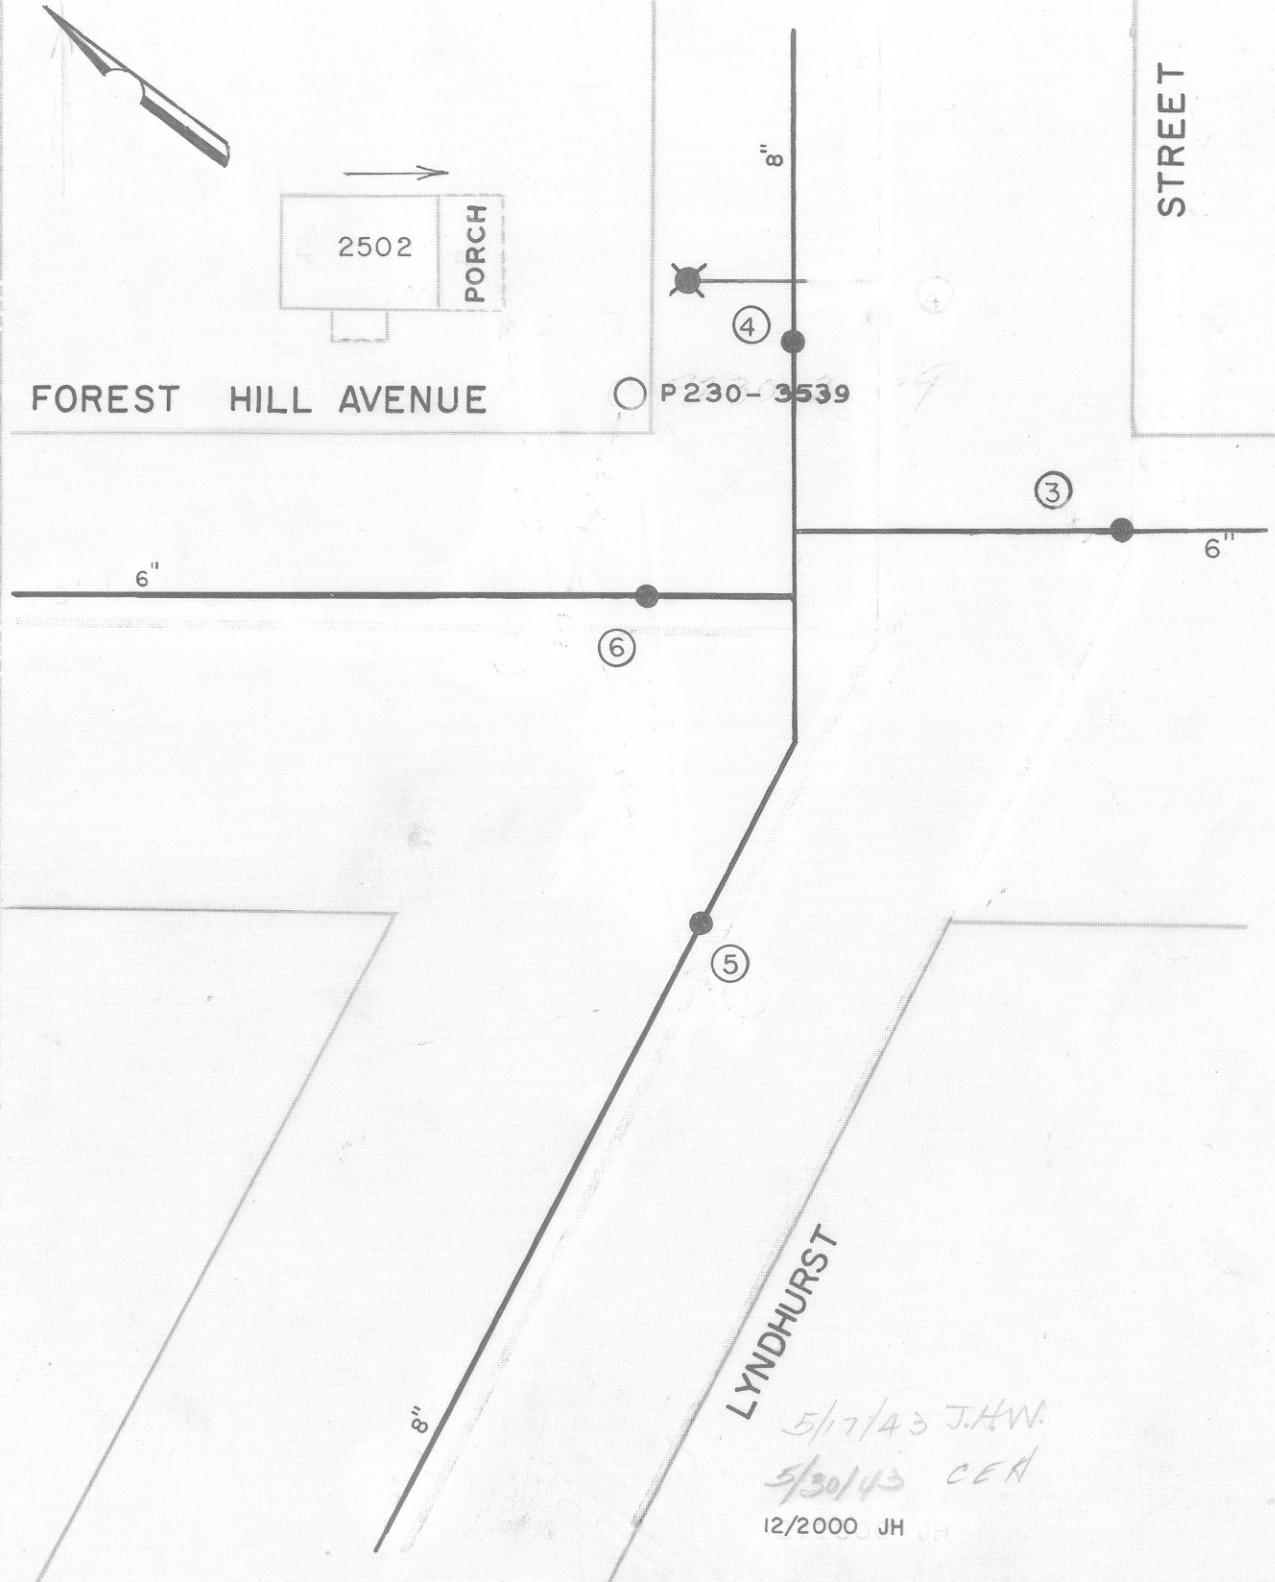

DATE	NO.	SIZE	MAKE	OPEN	TURNS
~~1926~~	~~1~~	~~2"~~		~~R~~	~~7~~
~~1926~~	~~2~~	~~2"~~		~~R~~	~~8~~
1954	3	6"		R	
1954	4	8"		R	
1954	5	8"		R	
1957	6	6"		R	

CITY OF ROANOKE—WATER DEP'T

VALVE DIAGRAM

FOREST HILL AVENUE & LYNDHURST STREET

N.W.

SEC. MAP 206,207 N.W.

DATE PAGE NO NW 79