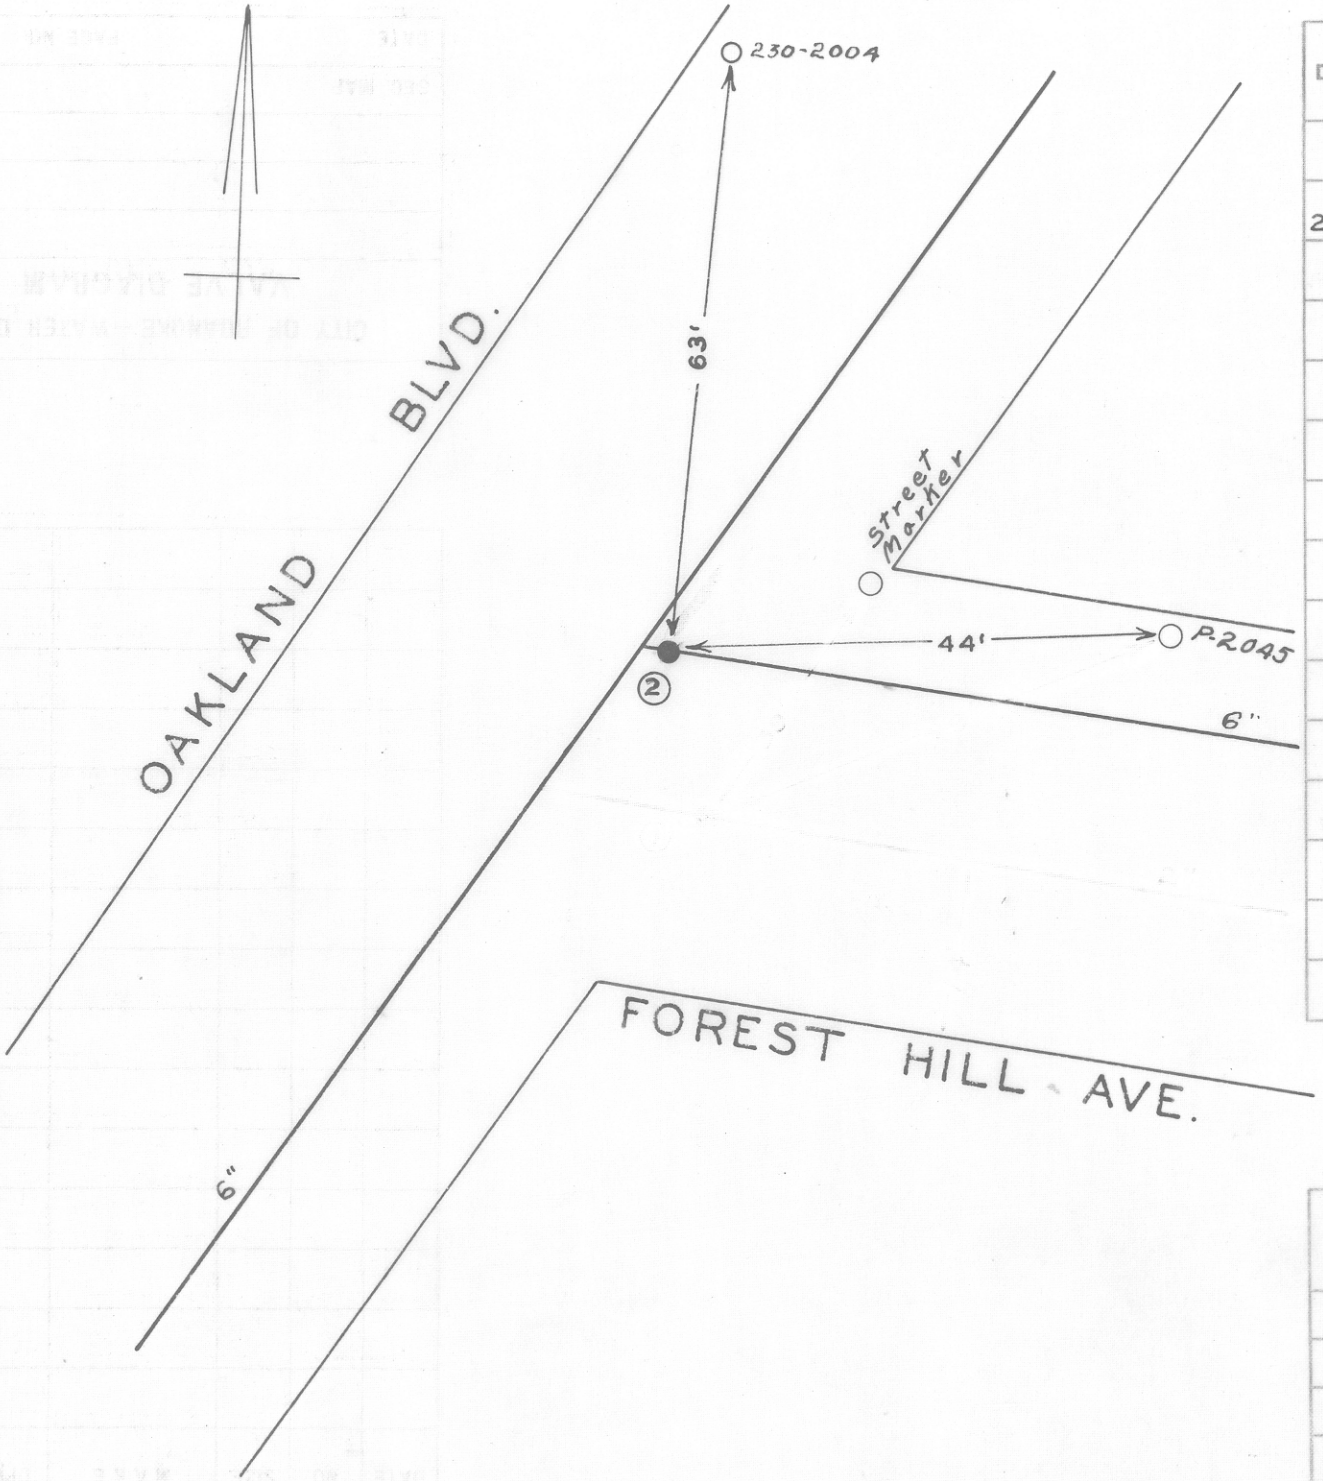

DATE	NO.	SIZE	MAKE	OPEN	TURNS
2-64	2	6"	DARLING	R	
	2	17'W.	E.P.L.		

CITY OF ROANOKE—WATER DEPT.

VALVE DIAGRAM

FOREST HILL AVE. &

OAKLAND BLVD. N.W.

SEC. MAP 215

DATE PAGE NO.