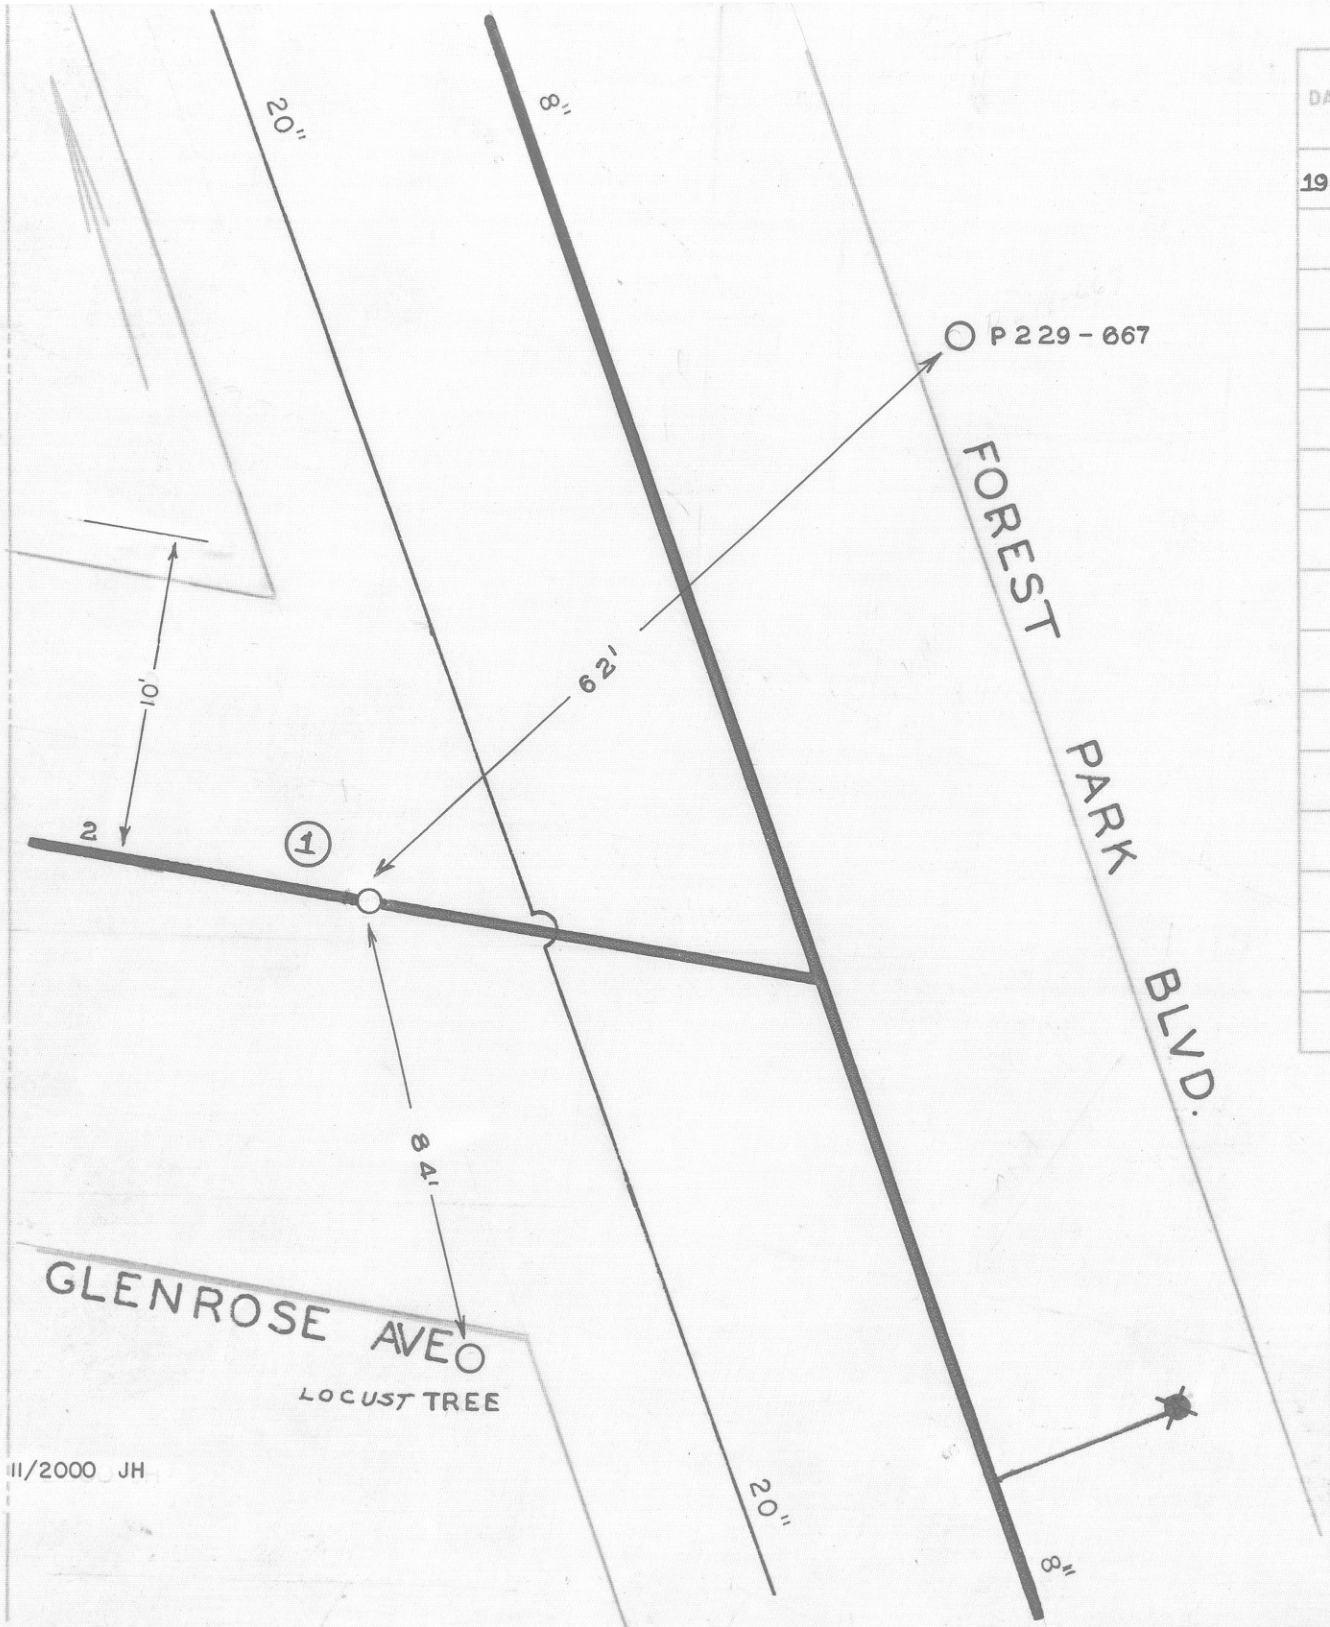

DATE	NO.	SIZE	MAKE	OPEN	TURNS
1948	1	2	DARLING	R	7
	1	0	WPL		

CITY OF ROANOKE—WATER DEP'T

VALVE DIAGRAM

FOREST PARK BOULEVARD & GLENROSE AVENUE

SEC. MAP 244 N.W.

DATE 6/5/48 PAGE NO N.W.305