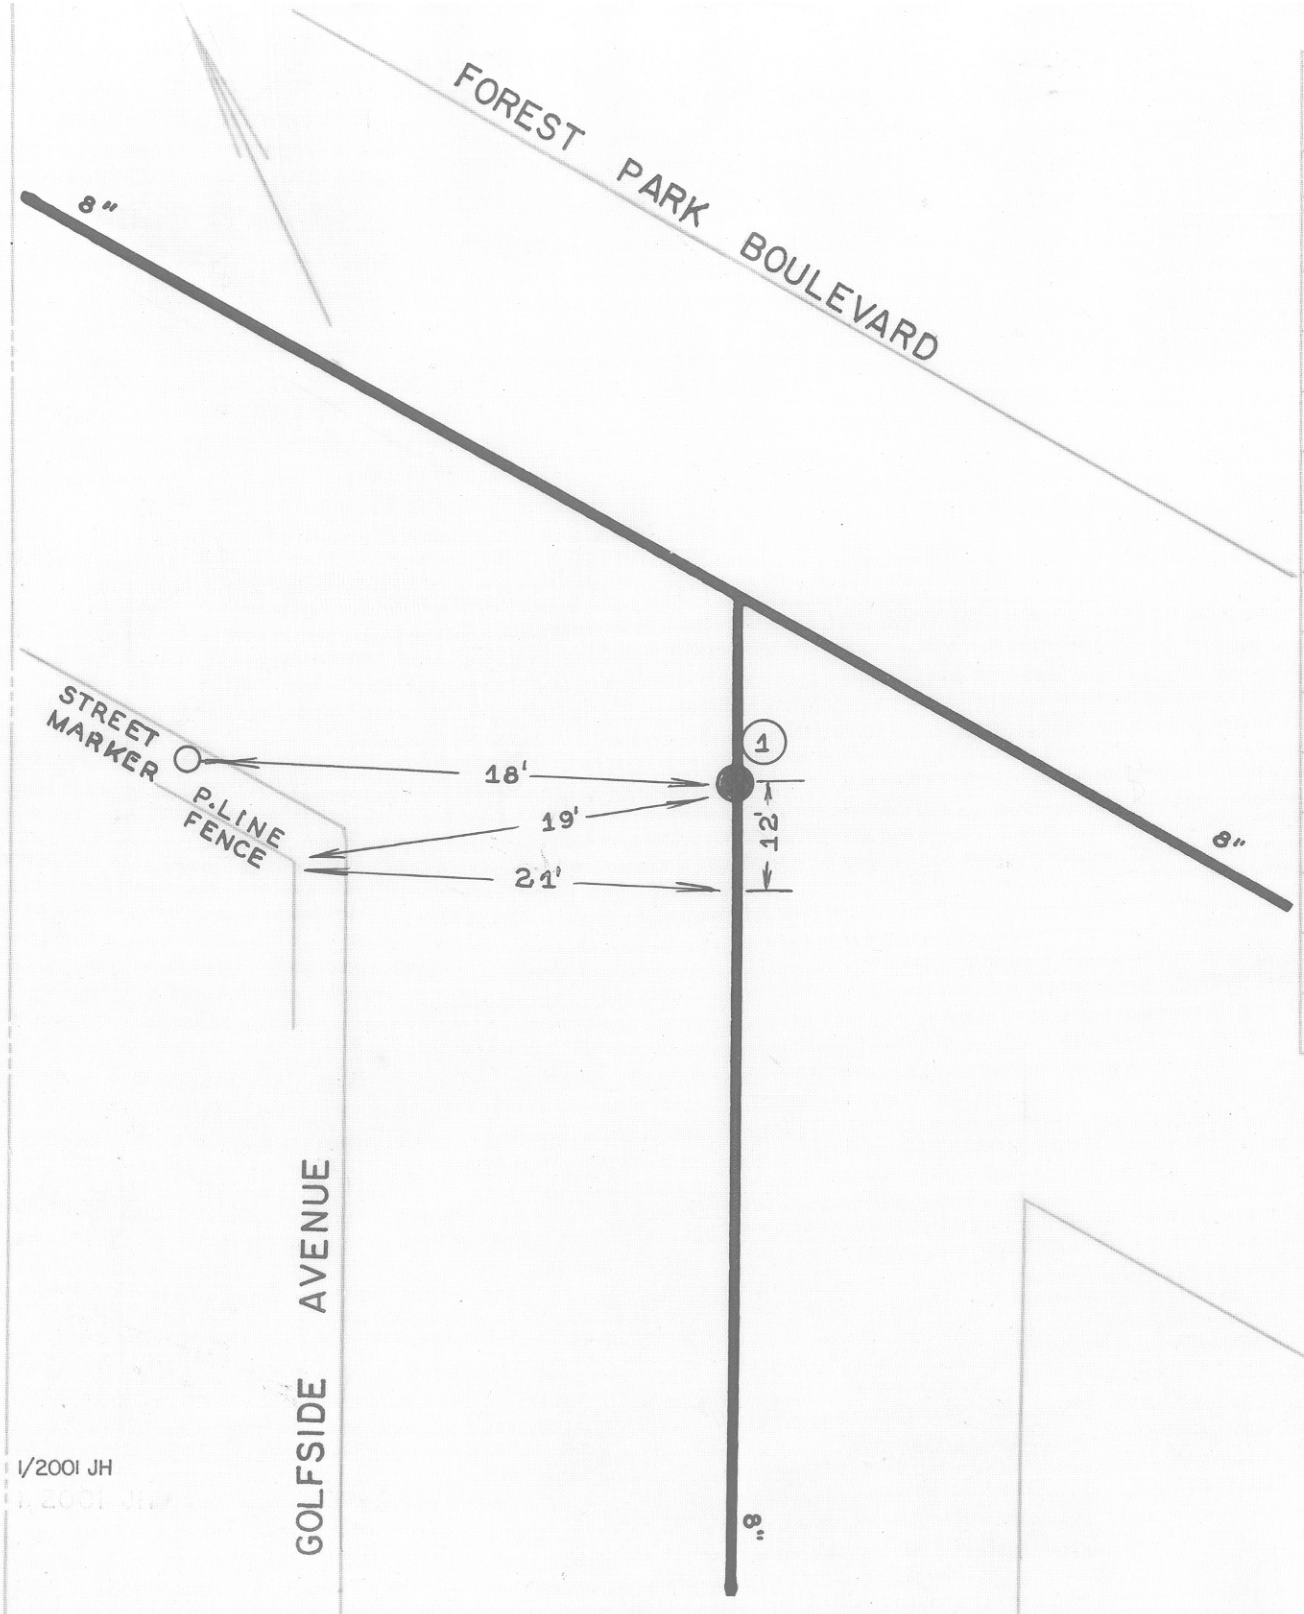

DATE	NO.	SIZE	MAKE	OPEN	TURNS
1950	1	8"	DARLING	R	27

CITY OF ROANOKE—WATER DEP'T

VALVE DIAGRAM

FOREST PARK BOULEVARD

& GOLFSIDE AVENUE N.W.

SEC. MAP 244 N.W.

DATE PAGE NO. NW341