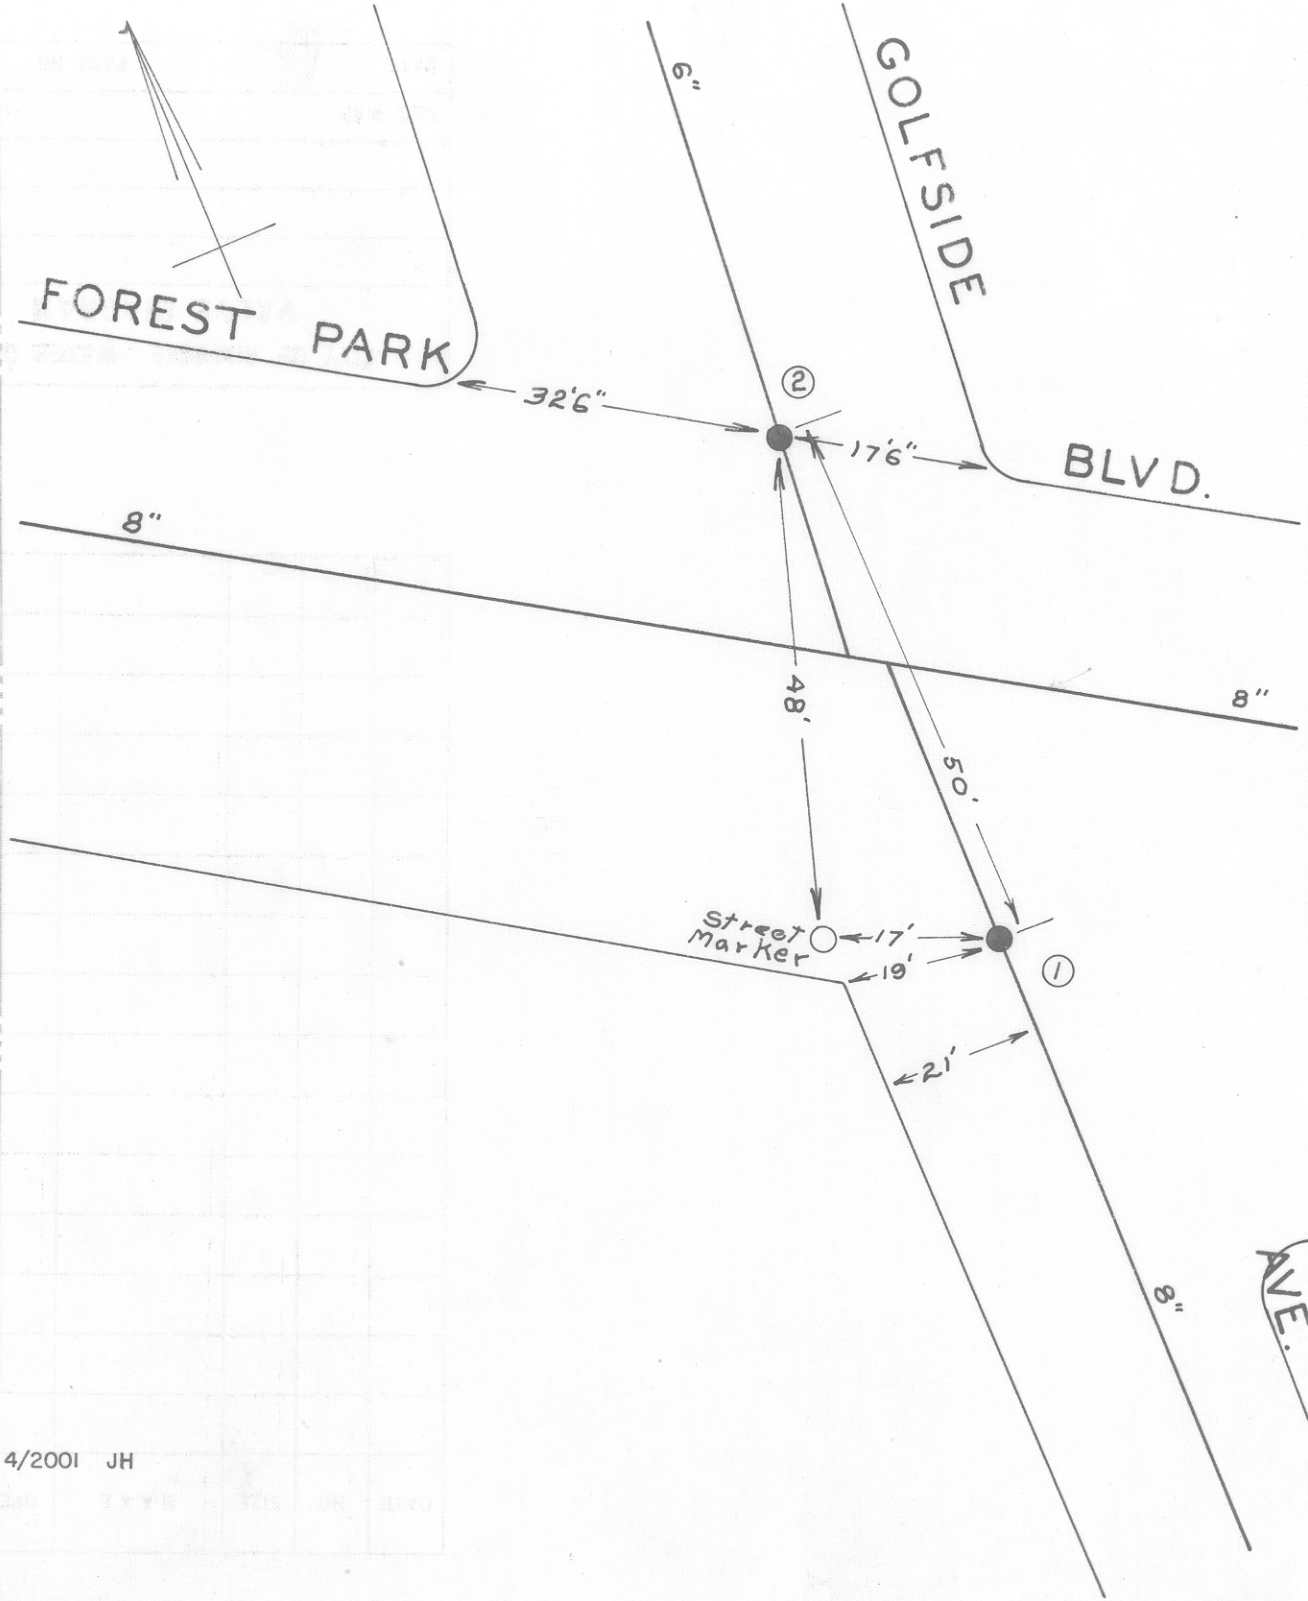

DATE	NO.	SIZE	MAKE	OPEN	TURNS
1950	1	8"	DARLING	R	27
1956	2	6"	MUELLER	R	
	1	9'-N	SPL		
	2	0	NPL		

CITY OF ROANOKE—WATER DEPT.

VALVE DIAGRAM

FOREST PARK BLVD. &

GOLFSIDE AVE. N.W.

SEC. MAP 246 N.W.

DATE PAGE NO.

4/2001 JH

"IMPERIAL" TRACING CLOTH K & E CO., N.Y.