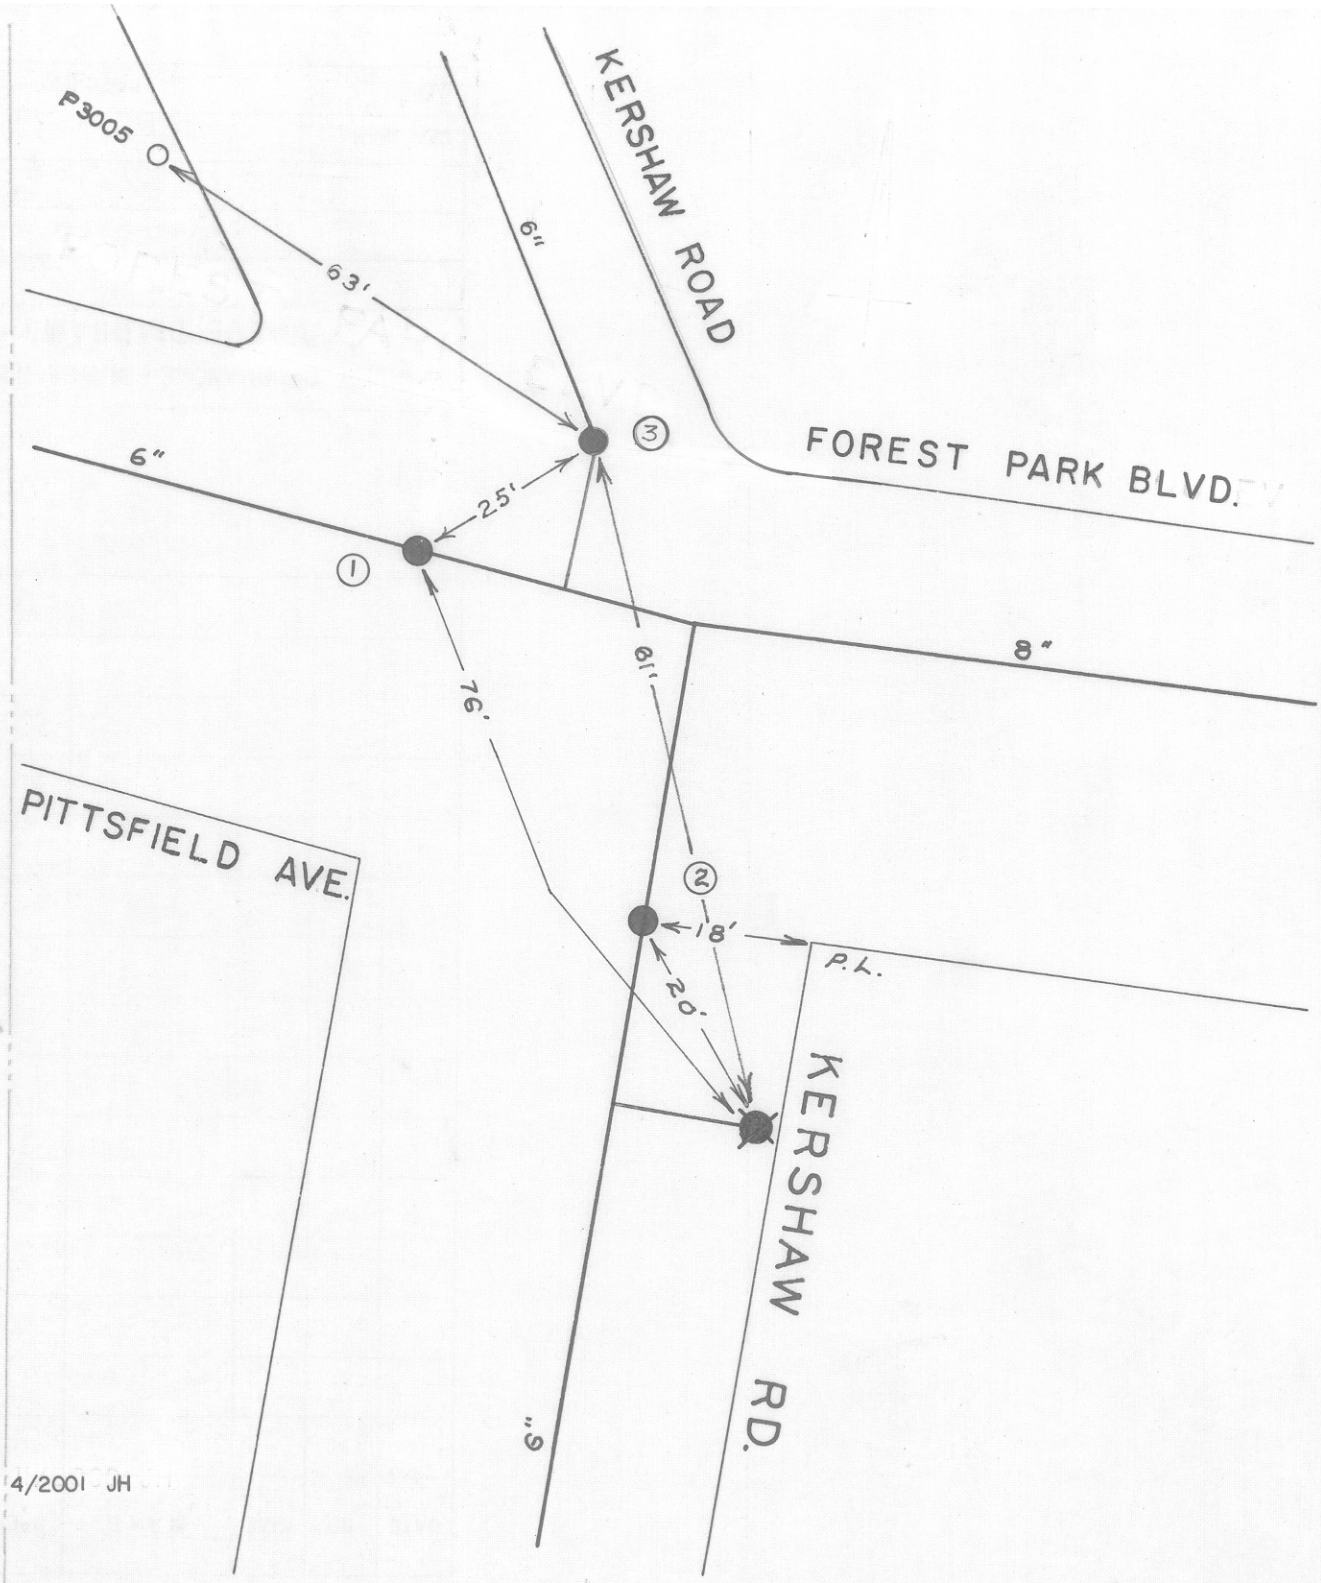

DATE	NO.	SIZE	MAKE	OPEN	TURNS
1955	1	6"	MUELLER		
1955	2	6"	MUELLER		
9-66	3	6"			
	1	0	NPL		
	2	0	SPL		

CITY OF ROANOKE—WATER DEPT.

VALVE DIAGRAM

FOREST PARK BLVD. &

KERSHAW RD. N.W.

SEC. MAP 256 N.W.

DATE PAGE NO.

4/2001 JH

"IMPERIAL" TRACING CLOTH K & E CO., N. Y.