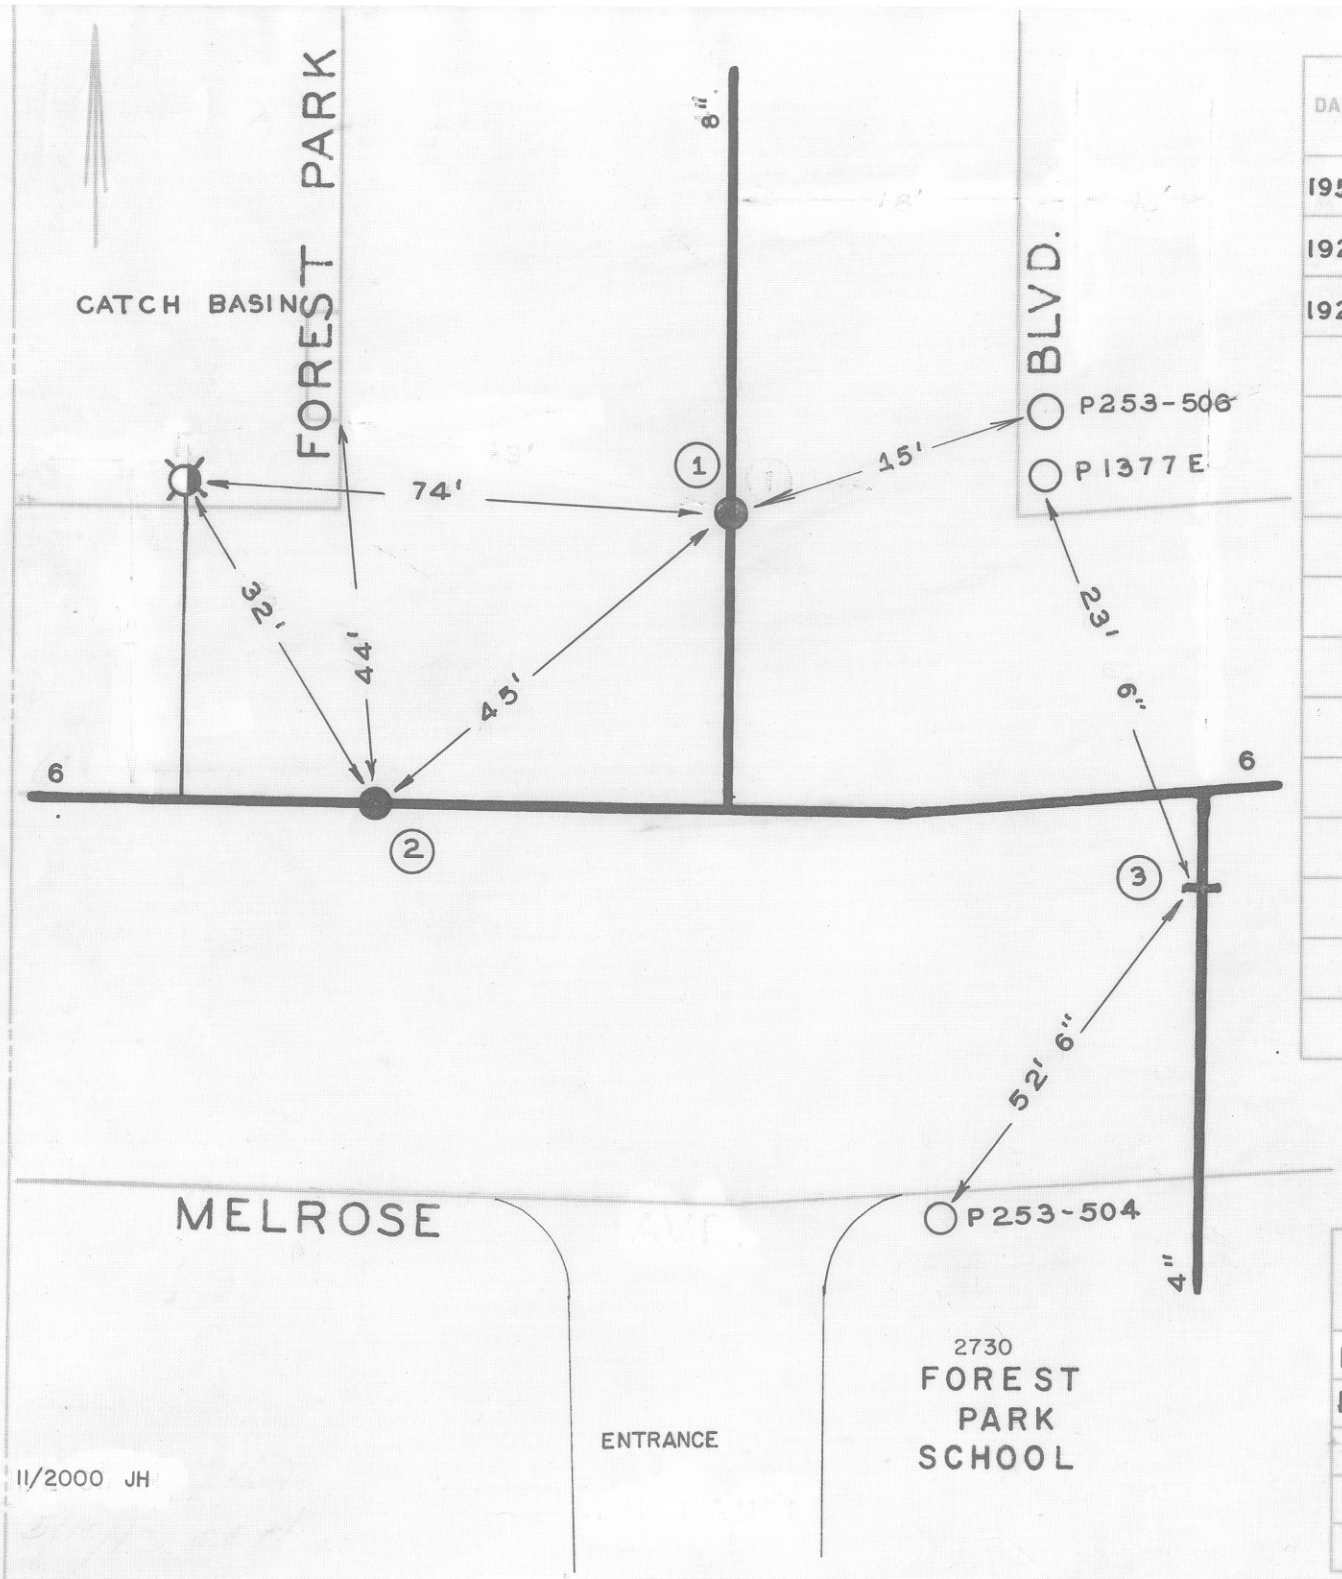

DATE	NO.	SIZE	MAKE	OPEN	TURNS
1950	1	8"	DARLING	R	26 1/2
1924	2	6"	DARLING	R	19 1/2
1924	3	4"	BROKEN		
	1	15'-N	NPL		
	2	0	WPL		
	3	17'-S	NPL		

CITY OF ROANOKE—WATER DEP'T

VALVE DIAGRAM

FOREST PARK BLVD. &
MELROSE AVE.

SEC. MAP 243, 242, 253

DATE PAGE NO NW 246

11/2000 JH