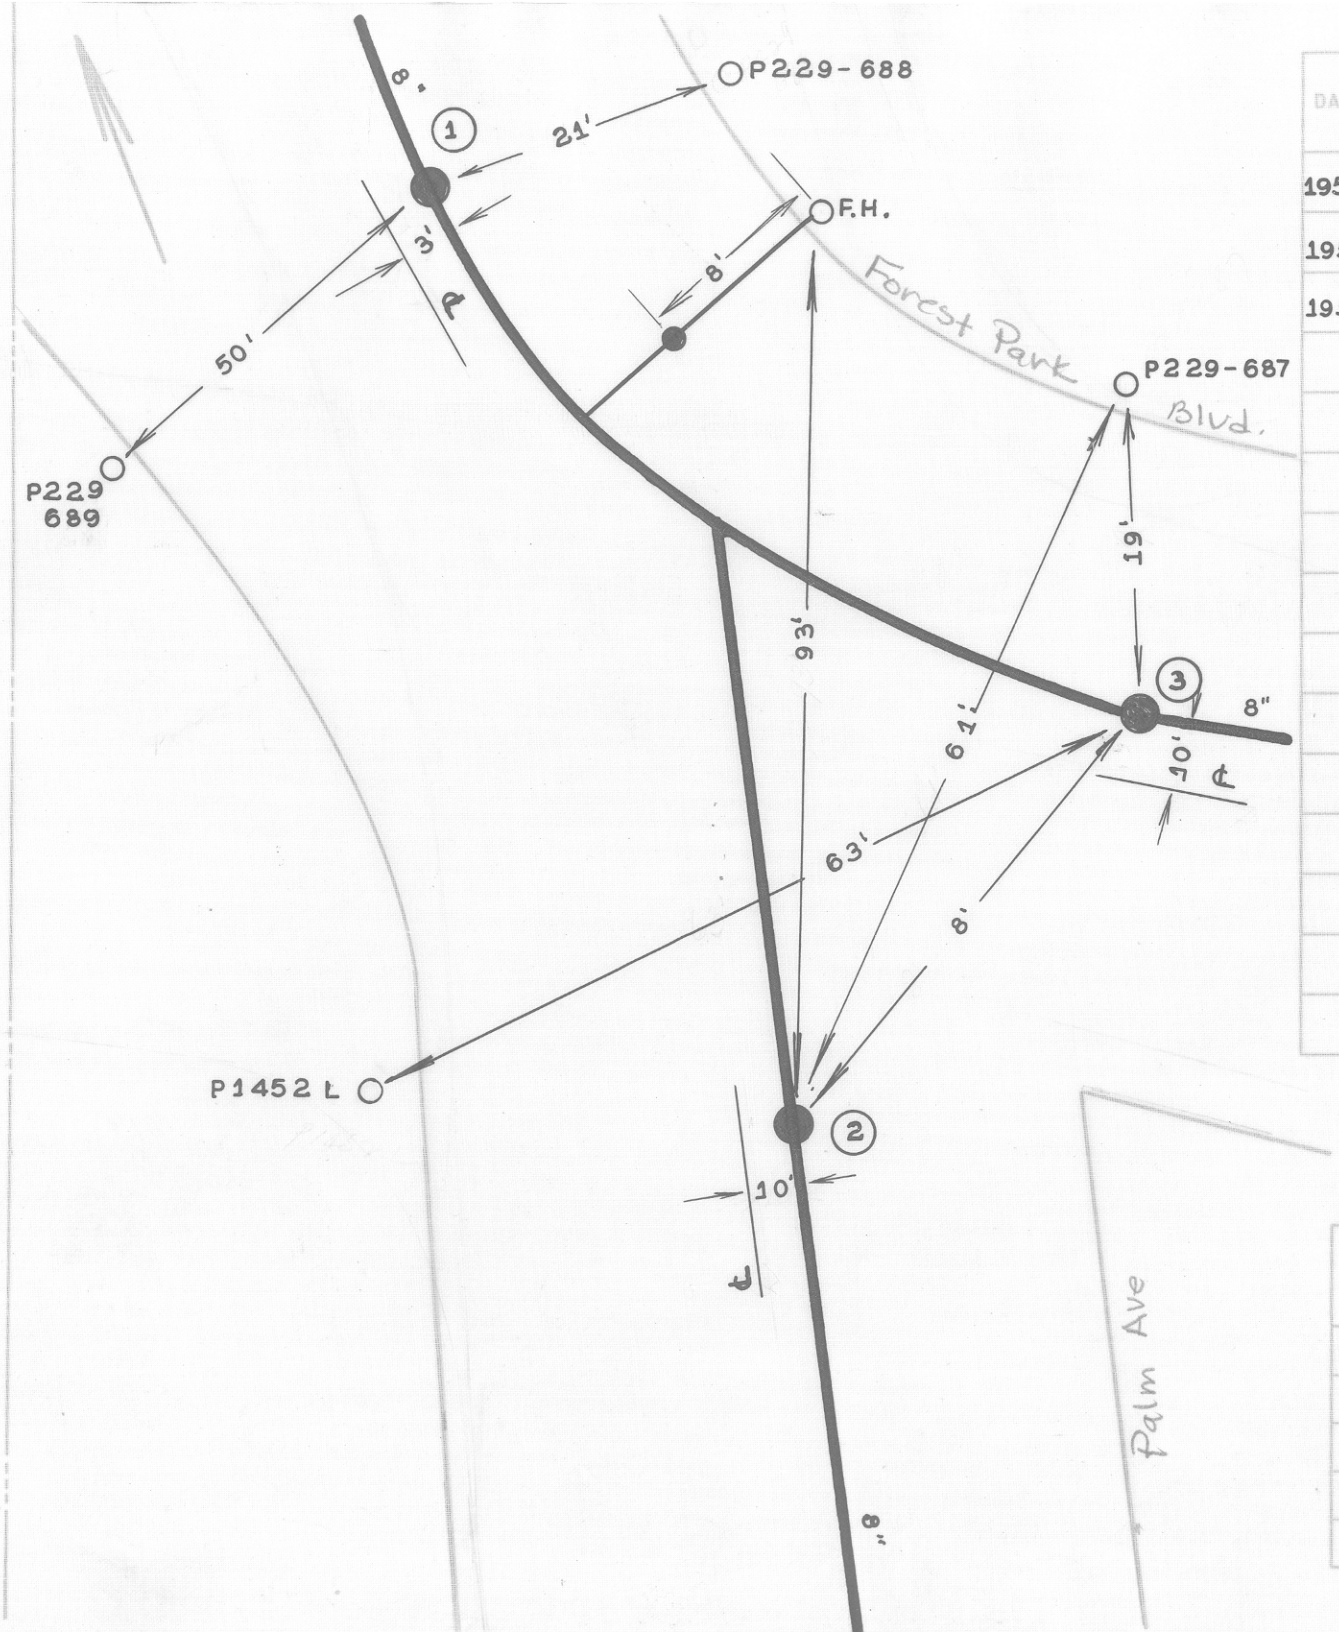

DATE	NO.	SIZE	MAKE	OPEN	TURNS
1950	1	8"	DARLING	R	27
1950	2	8"	DARLING	R	27
1950	3	8"	DARLING	R	27

CITY OF ROANOKE—WATER DEP'T

VALVE DIAGRAM

FOREST PARK BOULEVARD & PALM AVENUE N. W.

SEC. MAP 243

DATE

PAGE NO. NW 271