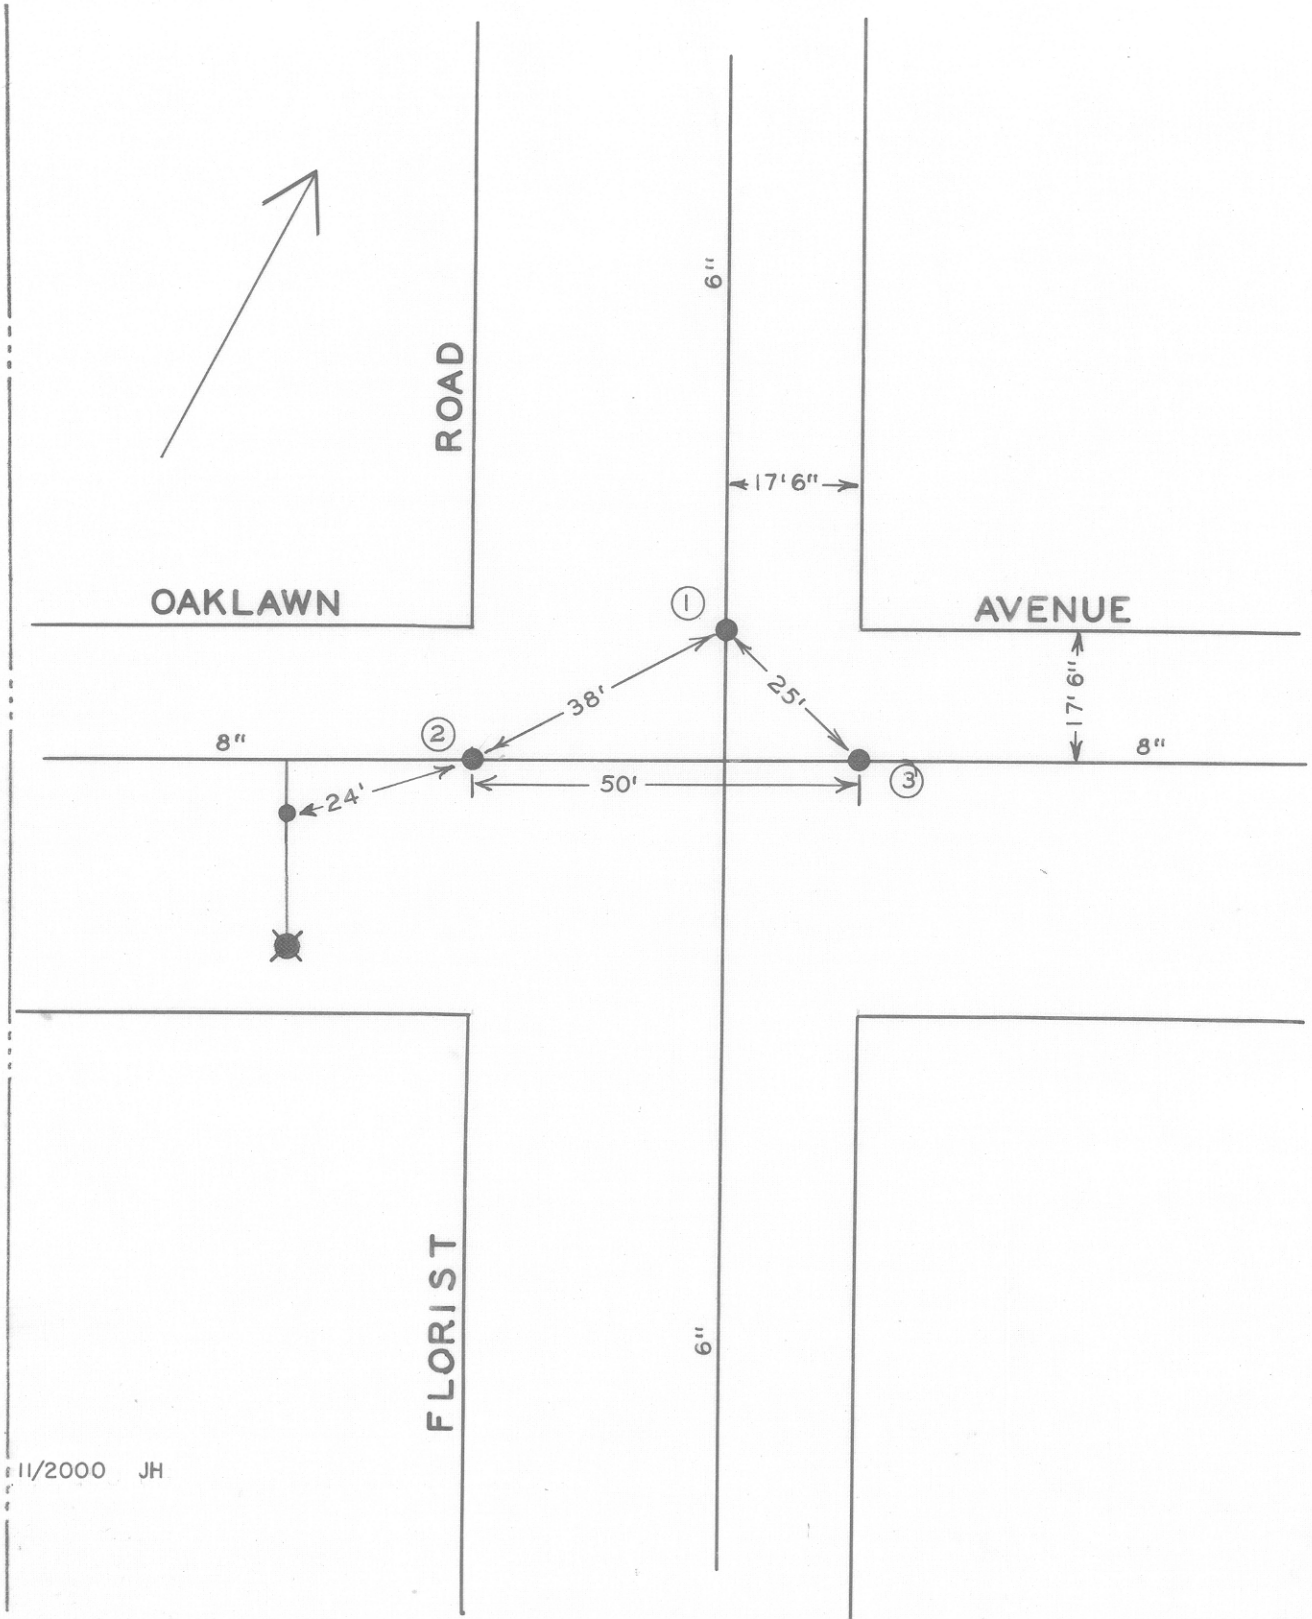

DATE	NO.	SIZE	MAKE	OPEN	TURNS
6-62	1	6"	DARLING	R	
6-62	2	8"	DARLING	R	
6-62	3	8	DARLING	R	
	1	0	N.P.L		
	2	0	W.P.L.		
	3	0	E.P.L.		

CITY OF ROANOKE—WATER DEPT.

VALVE DIAGRAM

FLORIST ROAD &

OAKLAWN AVENUE

SEC. MAP 218 N.W.

DATE PAGE NO.

11/2000 JH