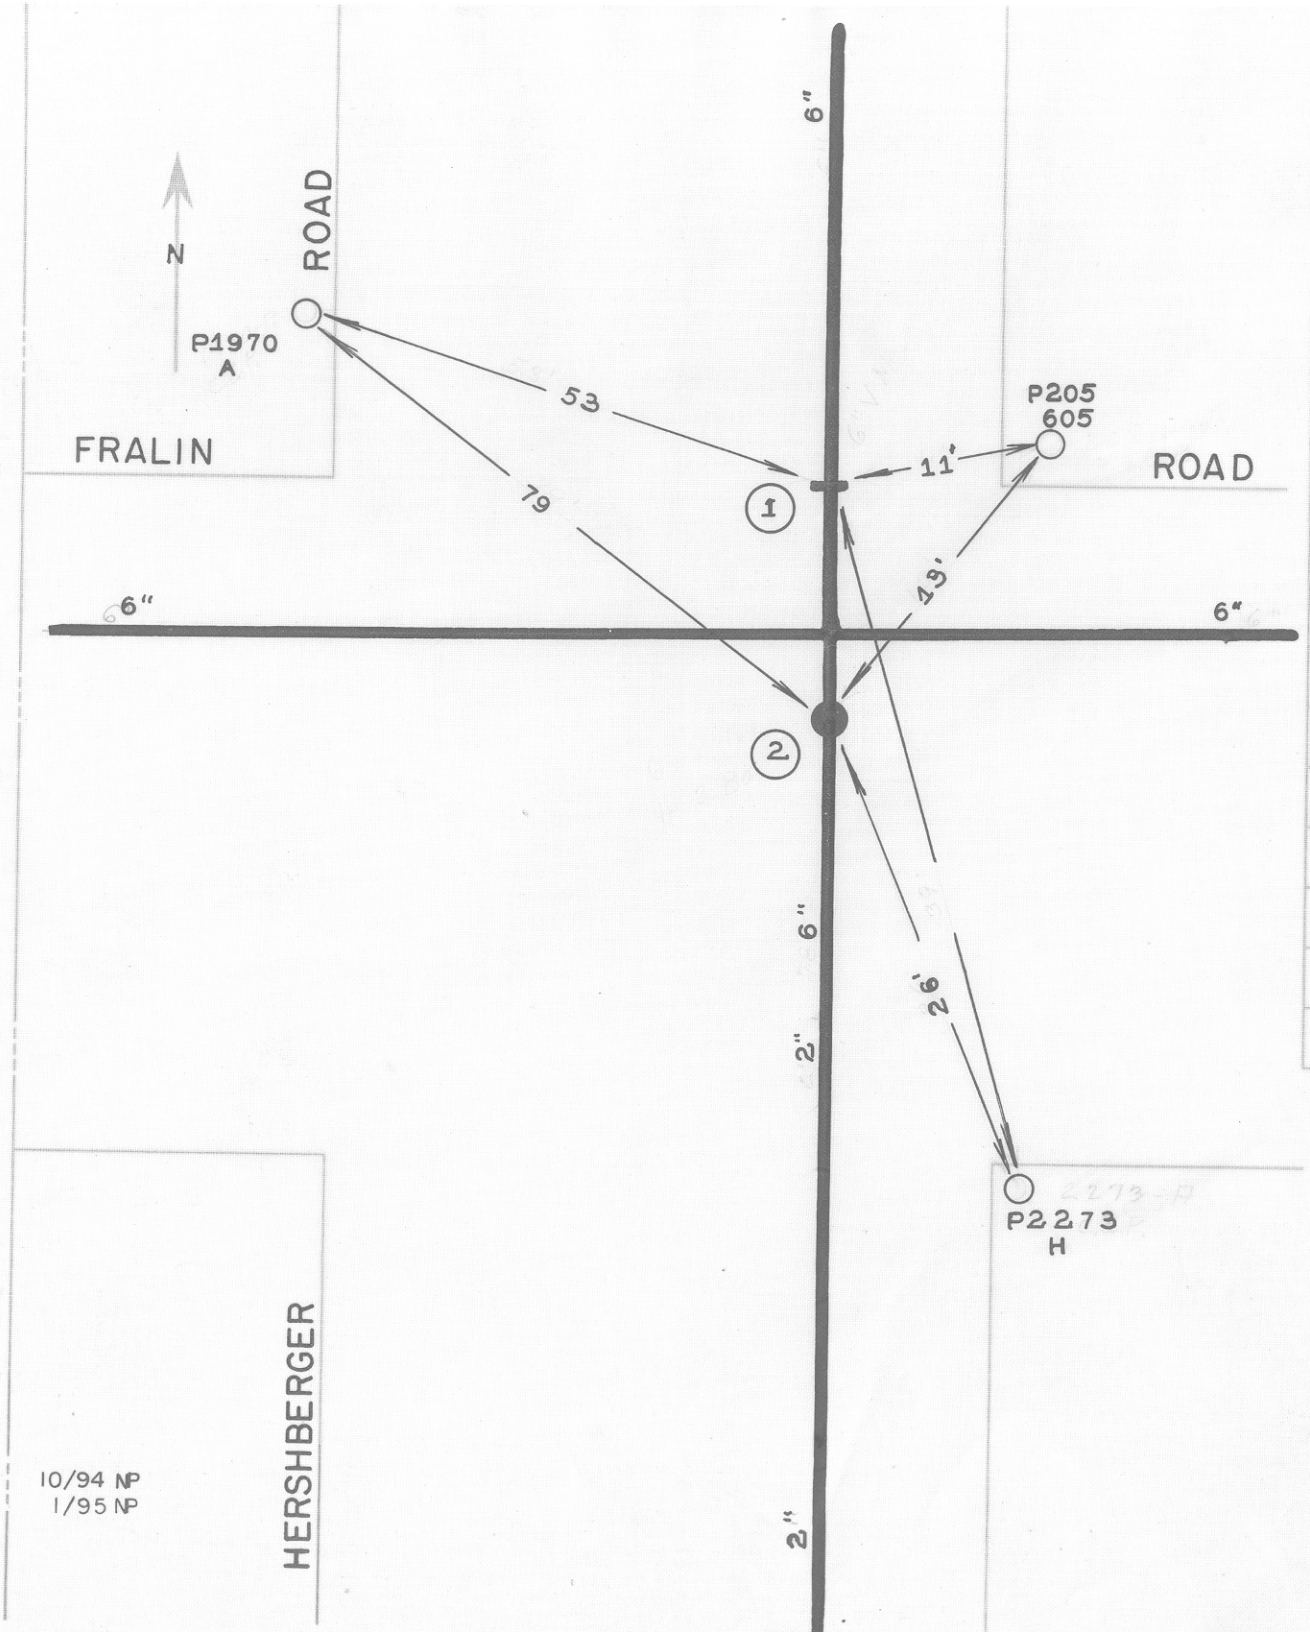

DATE	NO.	SIZE	MAKE	OPEN	TURNS
1951 W.R.	1	6"		L	21
1951 W.R.	2	6"		R	

10/94 NP
1/95 NP

CITY OF ROANOKE—WATER DEP'T

VALVE DIAGRAM

FRALIN ROAD &
HERSHBERGER ROAD N.W.

SEC. MAP 220

DATE W.R. PAGE NO. NW442