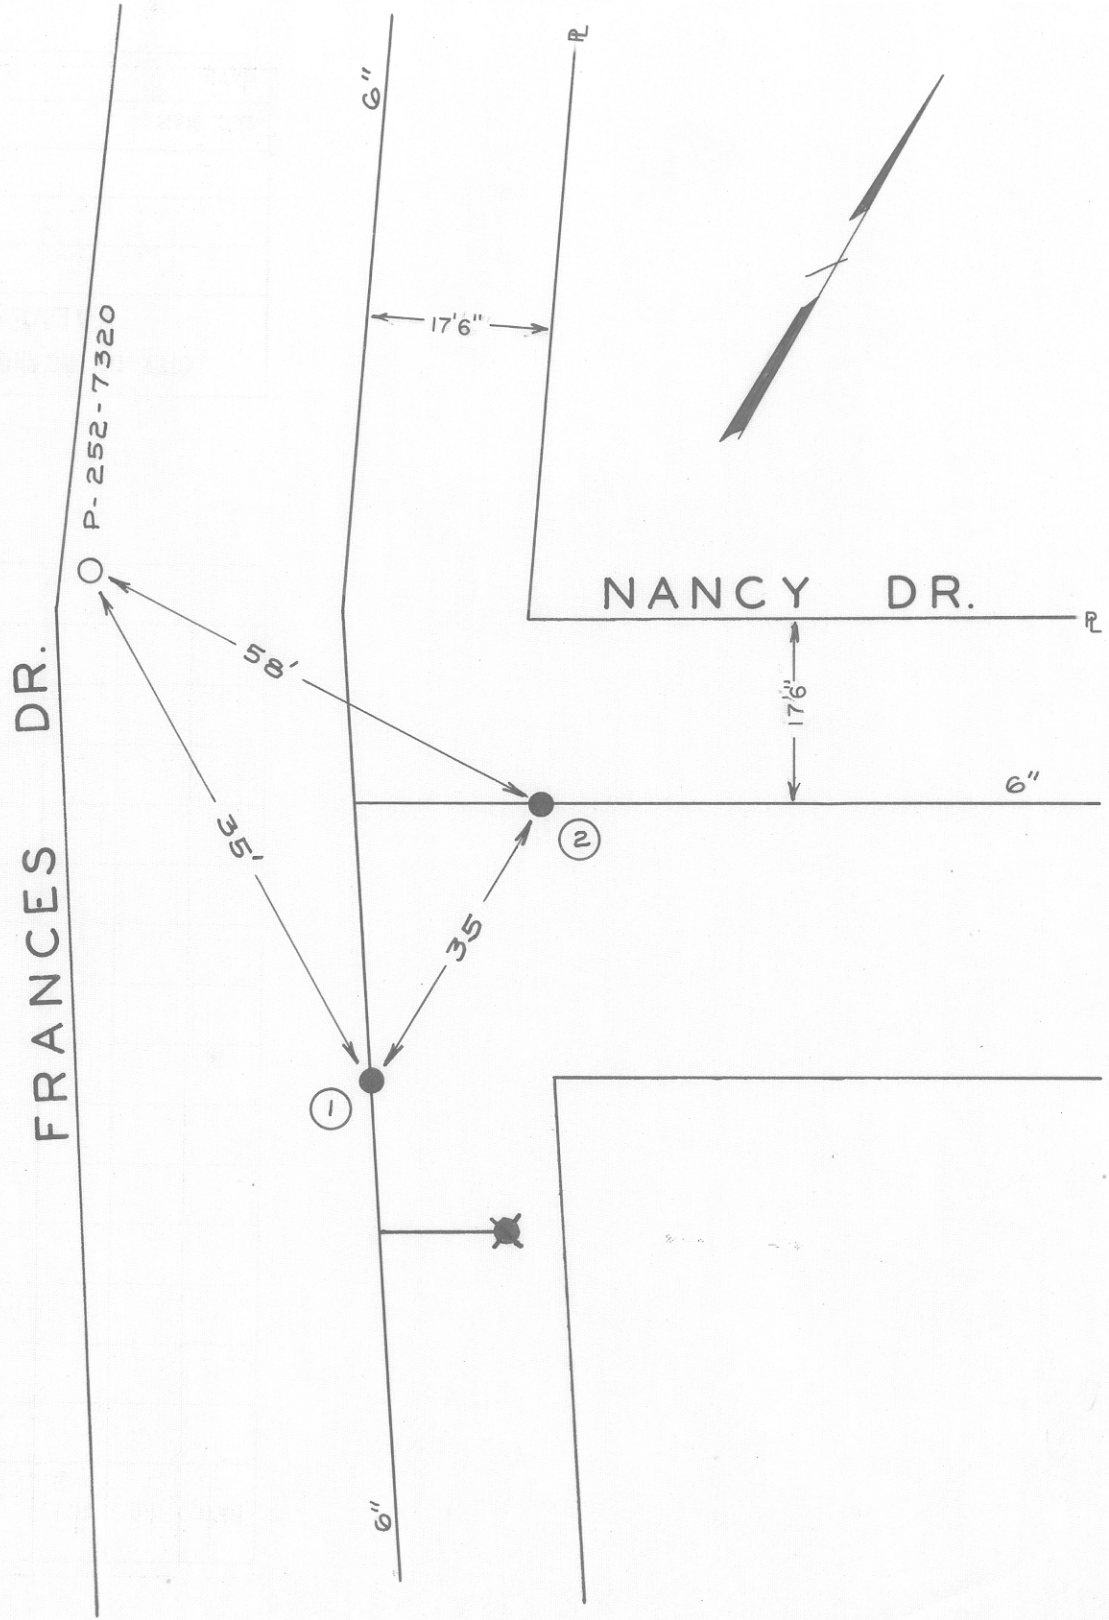

DATE	NO.	SIZE	MAKE	OPEN	TURNS
7-60	1	6"	MUE.	R	20
7-60	2	6"	MUE.	R	20
	1	0	SPL		
	2	0	EPL		

CITY OF ROANOKE—WATER DEPT.

VALVE DIAGRAM

FRANCES DR. & NANCY DRIVE N.W.

SEC. MAP 602 N.W.

DATE PAGE NO.

11/2000 JH