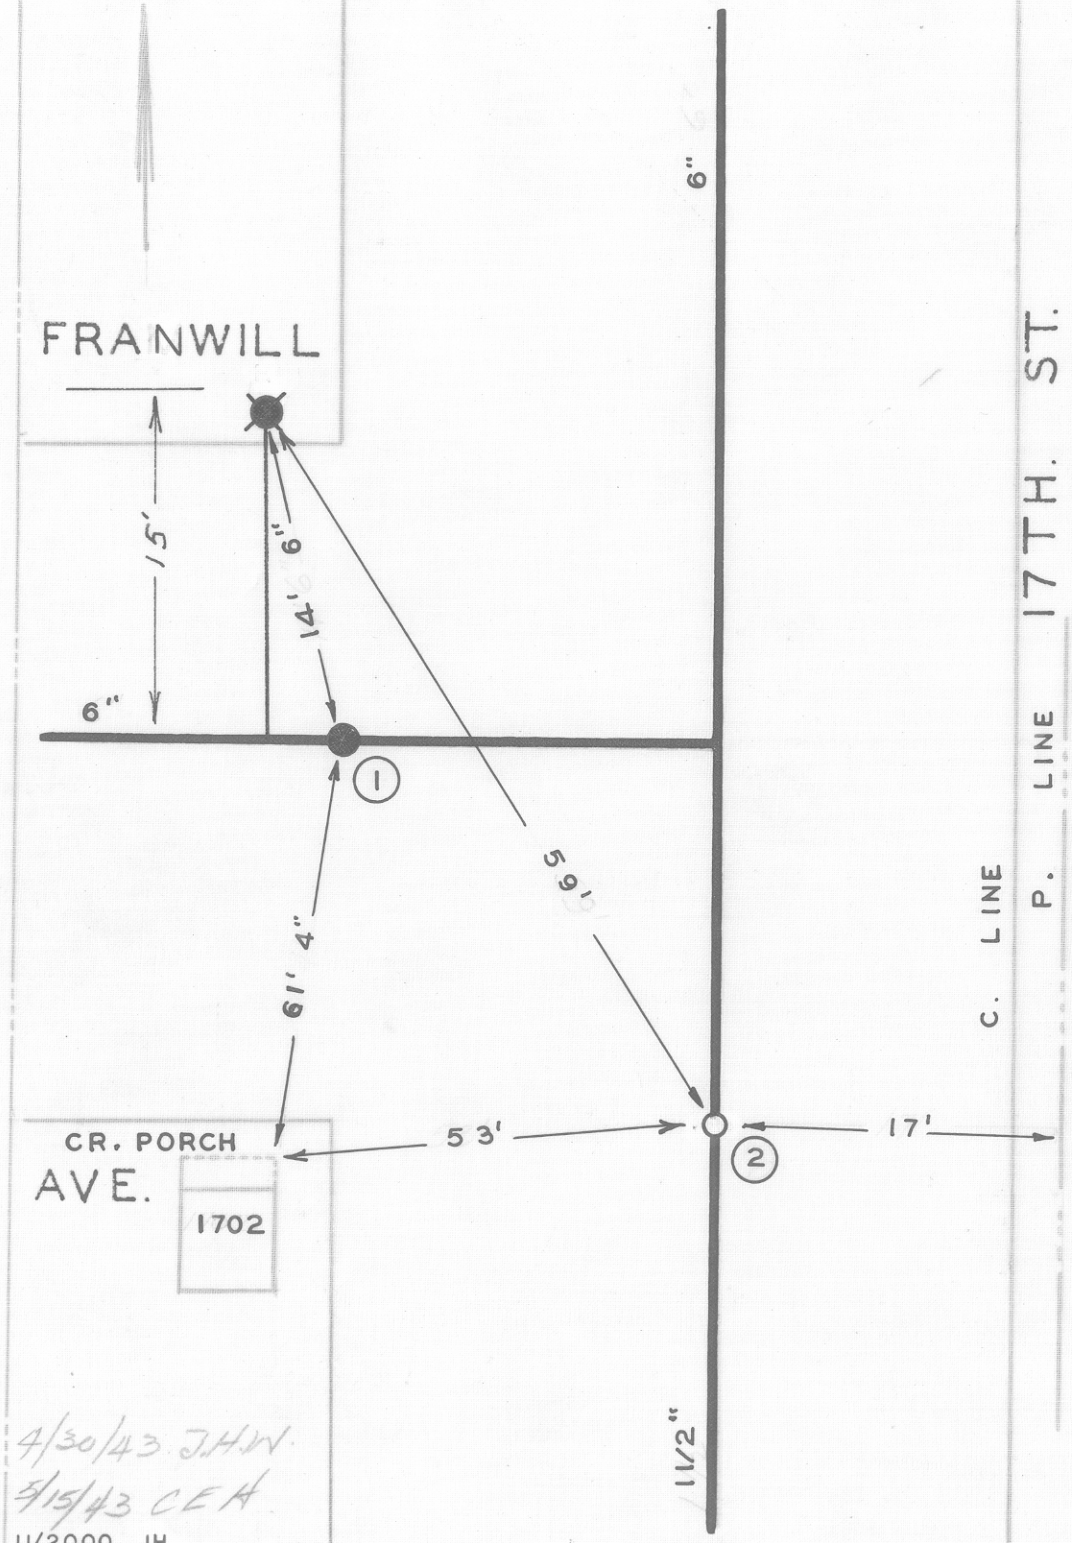

4/30/43 J.H.W.
5/15/43 CEH
11/2000 JH

DATE	NO.	SIZE	MAKE	OPEN	TURNS
1939	1	6"		R	20 1/2
1939	2	2"		R	7
	1	0	WPL		
	2	0	SPL		

CITY OF ROANOKE—WATER DEP'T
VALVE DIAGRAM

FRANWILL AVE. &
17TH STREET

SEC. MAP 233 N.W.

DATE PAGE NO. NW 234