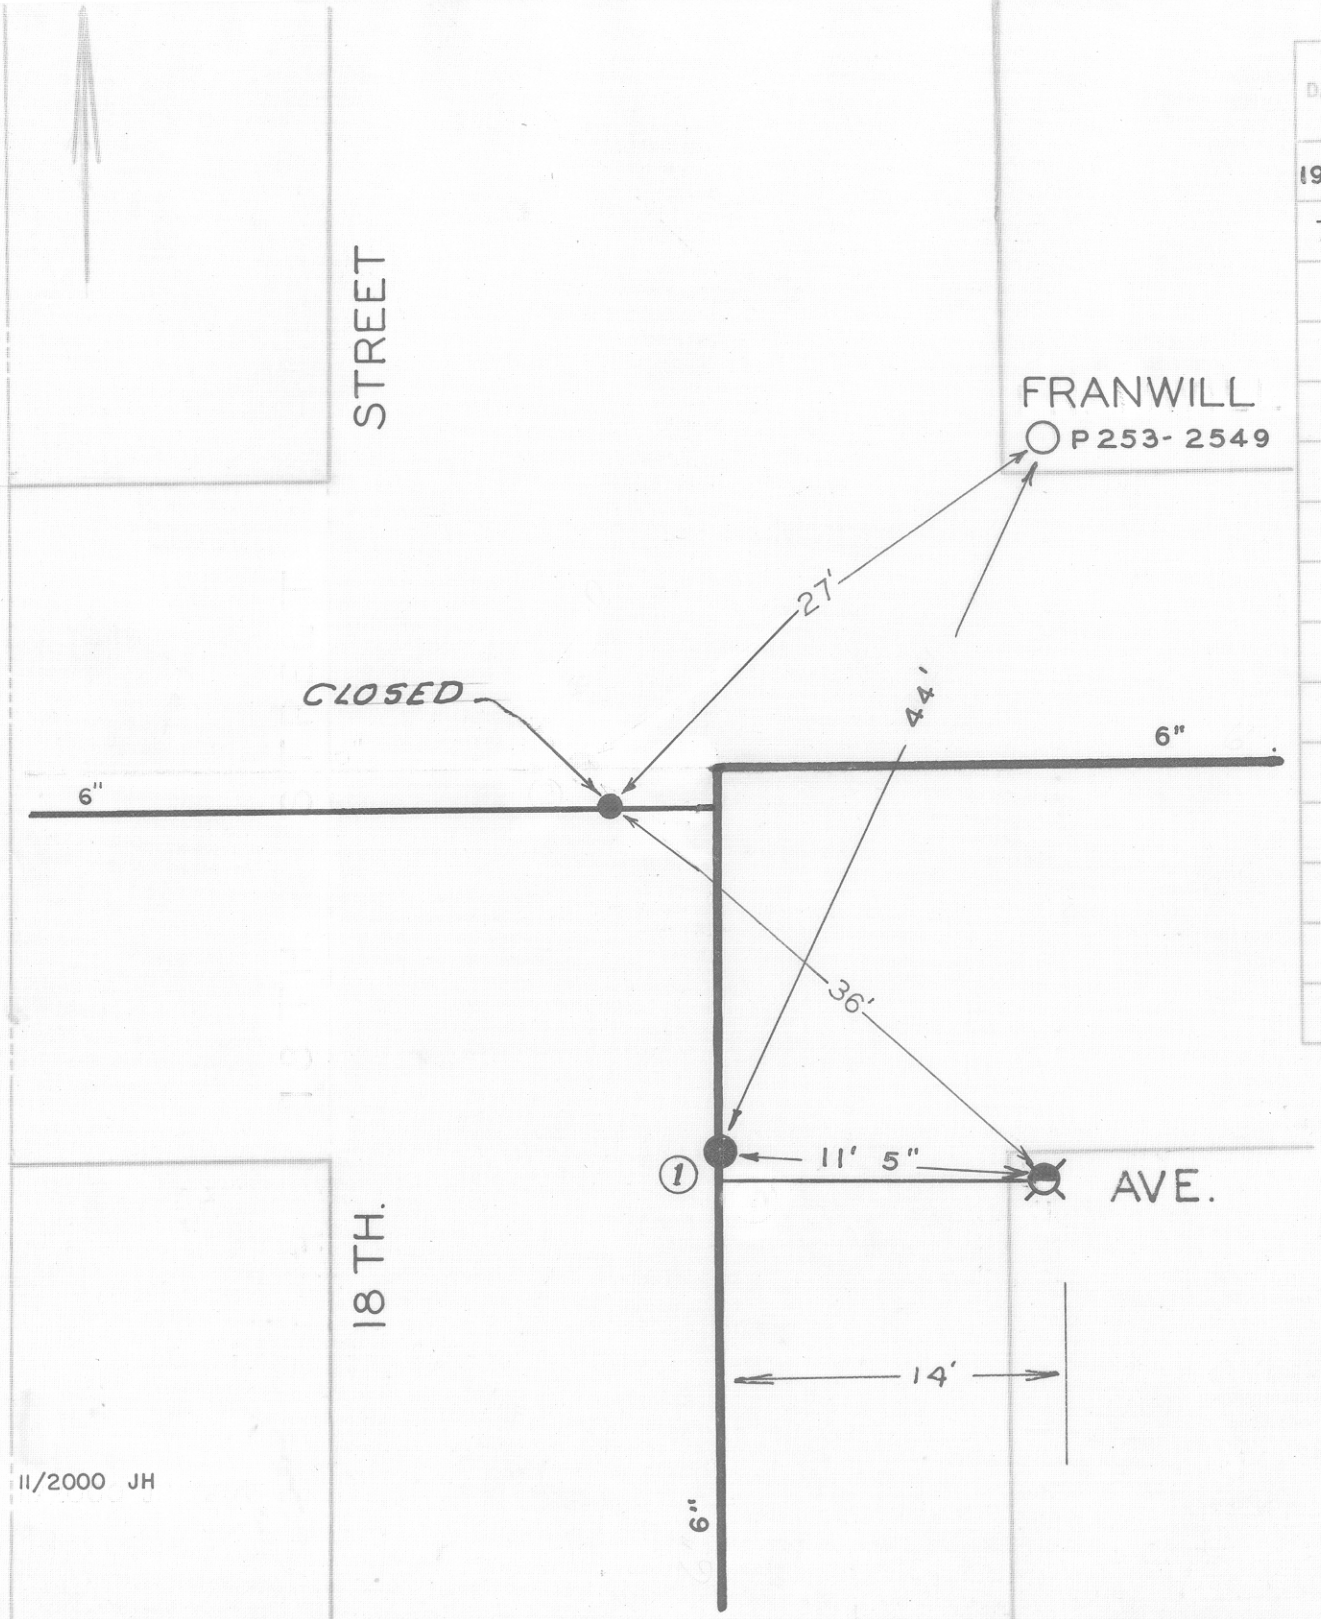

DATE	NO.	SIZE	MAKE	OPEN	TURNS
1939	1	6"		R	20
72	2	6"	MUELLER	R	
	1	0	SPL		

CITY OF ROANOKE—WATER DEP'T

VALVE DIAGRAM

FRANWILL AVE. &

18 TH ST.

SEC. MAP 233 N.W.

DATE PAGE NO. NW 235

11/2000 JH