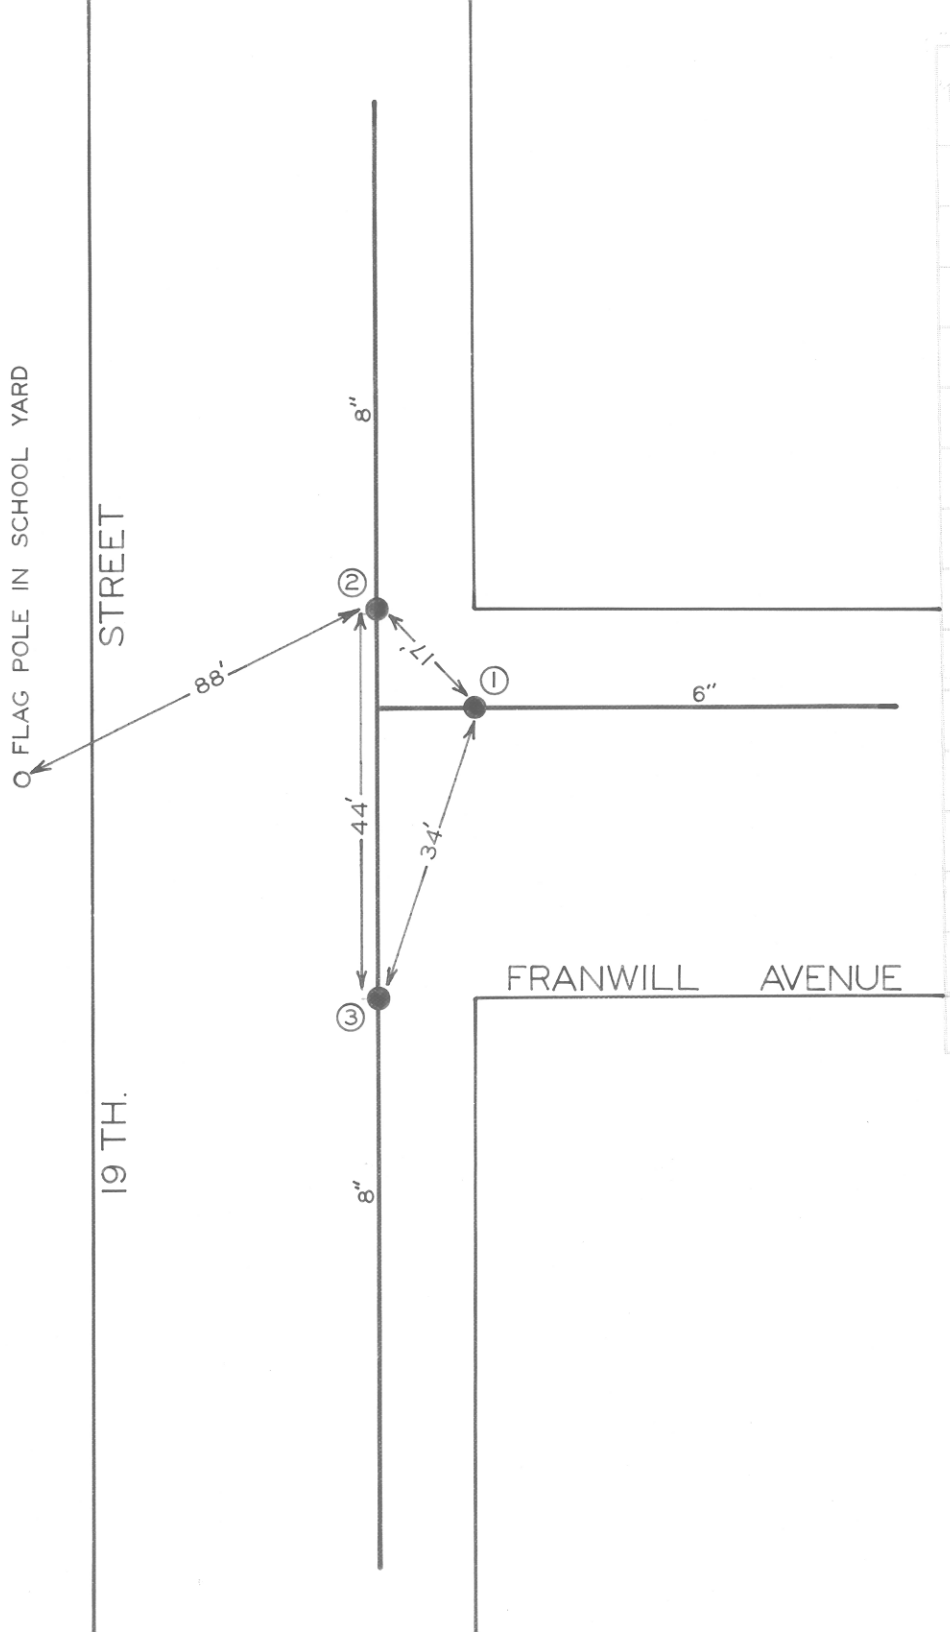

DATE	NO.	SIZE	MAKE	OPEN	TURNS
72	1	6"	MUELLER	R	
72	2	8"	MUELLER	R	
72	3	8"	MUELLER	R	

CITY OF ROANOKE — WATER DEP'T

VALVE DIAGRAM

FRANWILL AVENUE &
19 TH. STREET N.W.

SEC. MAP 233

DATE PAGE NO.