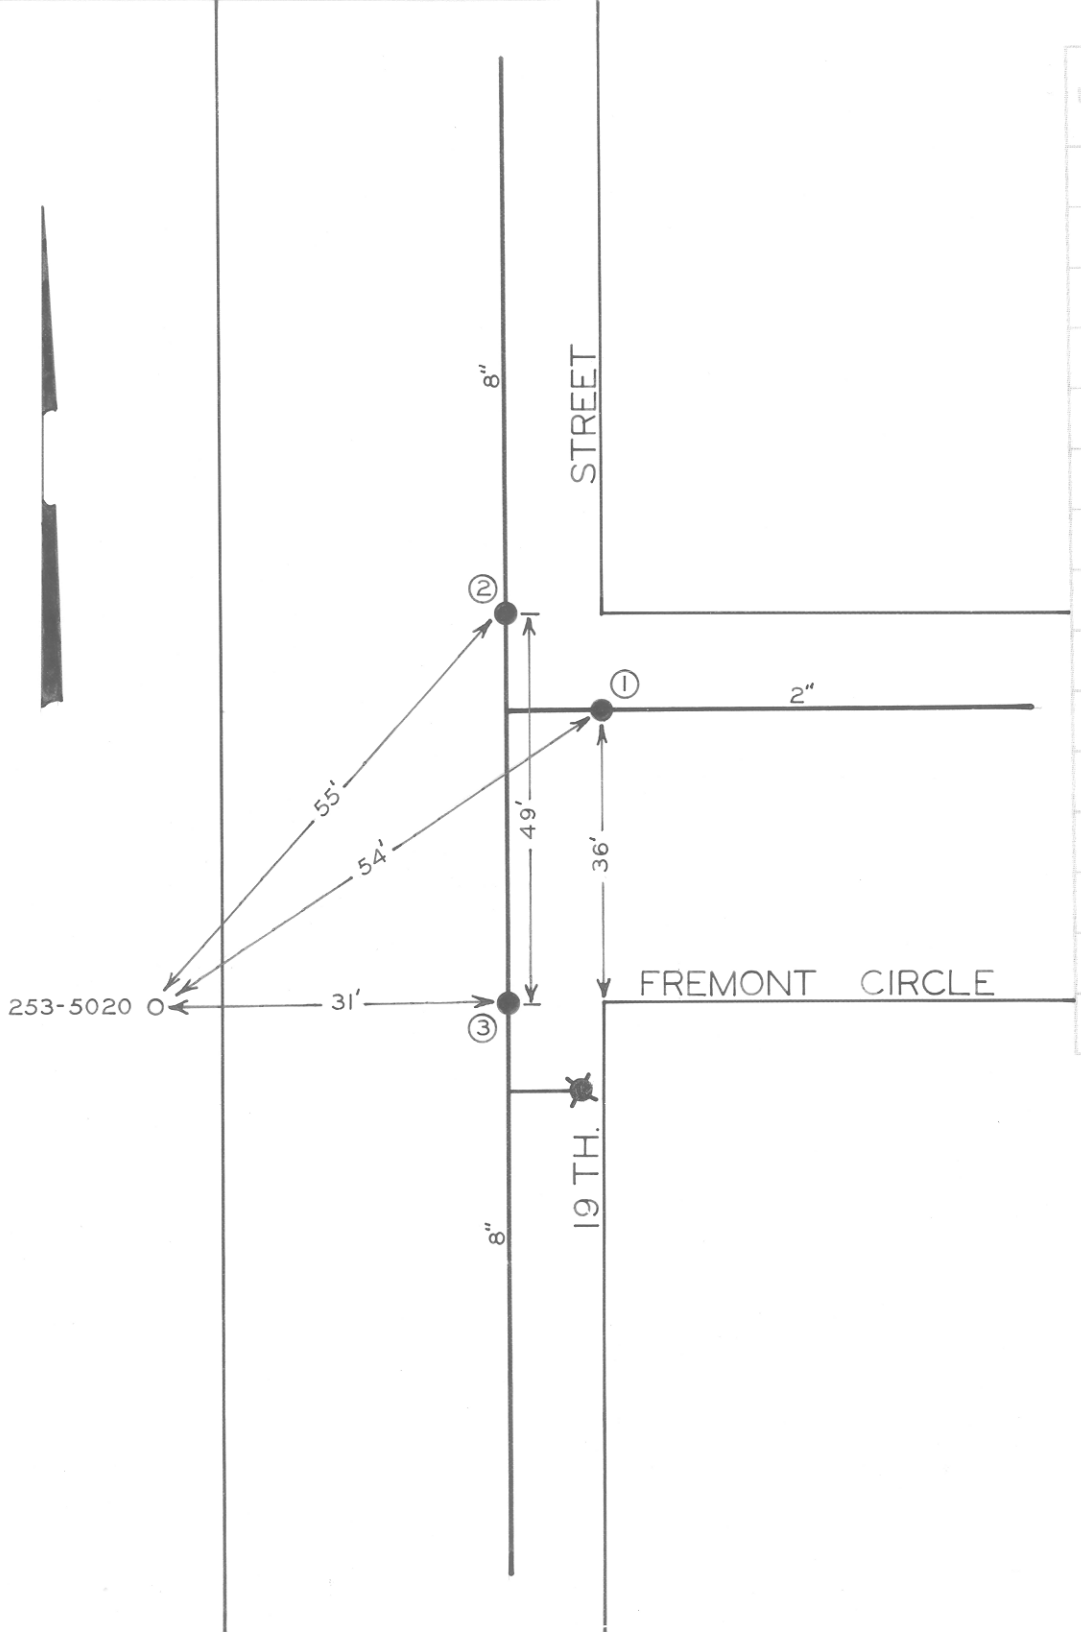

DATE	NO.	SIZE	MAKE	OPEN	TURNS
72	1	2"	MUELLER	R	
72	2	8"	MUELLER	R	
72	3	8"	MUELLER	R	

11/2000 JH

CITY OF ROANOKE—WATER DEP'T

VALVE DIAGRAM

FREMONT CIRCLE &

19 TH. STREET

SEC. MAP 233 N.W.

DATE PAGE NO.