| DATE | NO. | SIZE | MAKE | OPEN | TURNS |
|---|---|---|---|---|---|
| 72 | 1 | 8" | MUELLER | R | |
| 72 | 2 | 8" | MUELLER | R | |

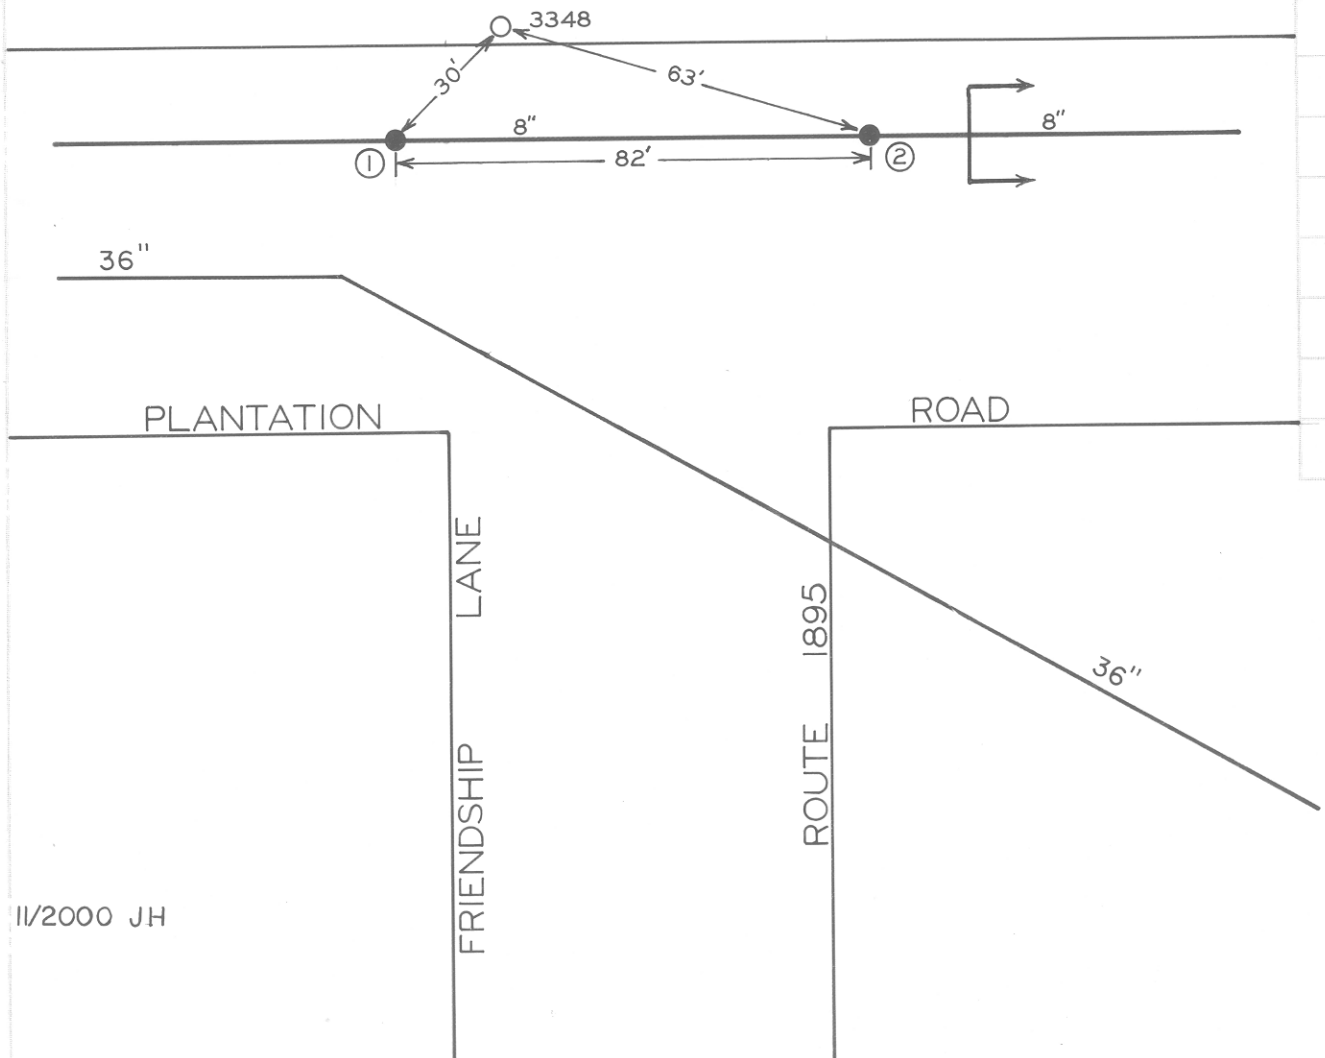


City maintained

CITY OF ROANOKE — WATER DEP'T
VALVE DIAGRAM

FRIENDSHIP LANE &
PLANTATION ROAD
N.W.

SEC. MAP R.C. 18.18 , 27.06

DATE PAGE NO.