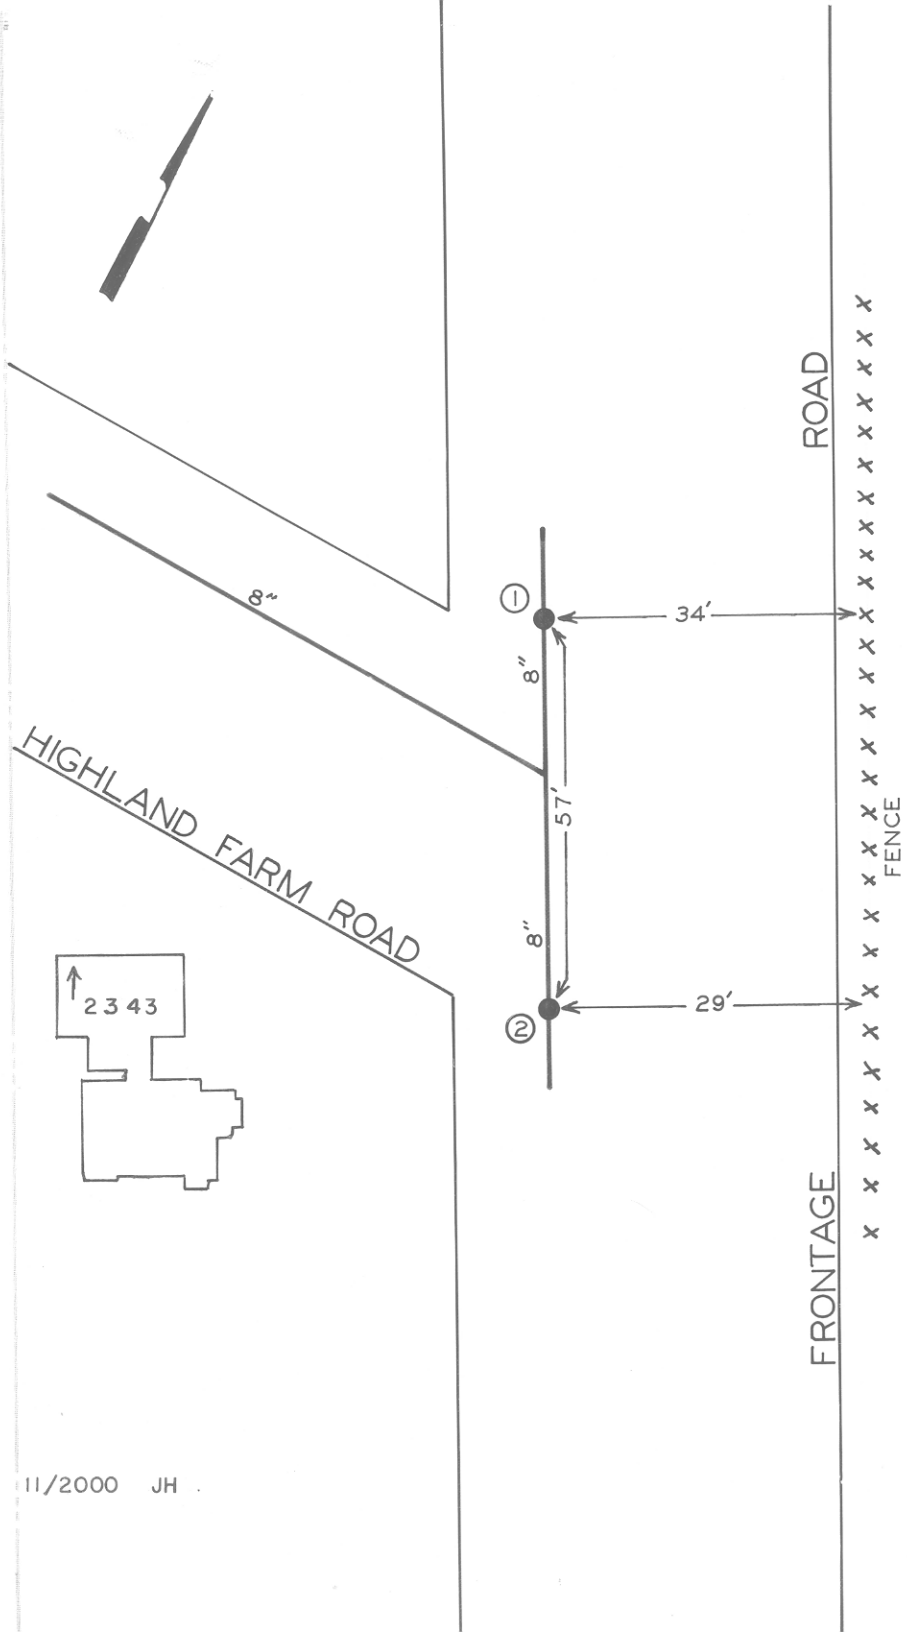


| DATE | NO | SIZE | MAKE | OPEN | TURNS |
|---|---|---|---|---|---|
| 69 | 1 | 8" | MUELLER | R | 27 |
| 69 | 2 | 8" | MUELLER | R | 27 |

CITY OF ROANOKE—WATER DEP'T

VALVE DIAGRAM

FRONTAGE ROAD &
HIGHLAND FARM ROAD

SEC. MAP 647 N. W.

DATE PAGE NO.