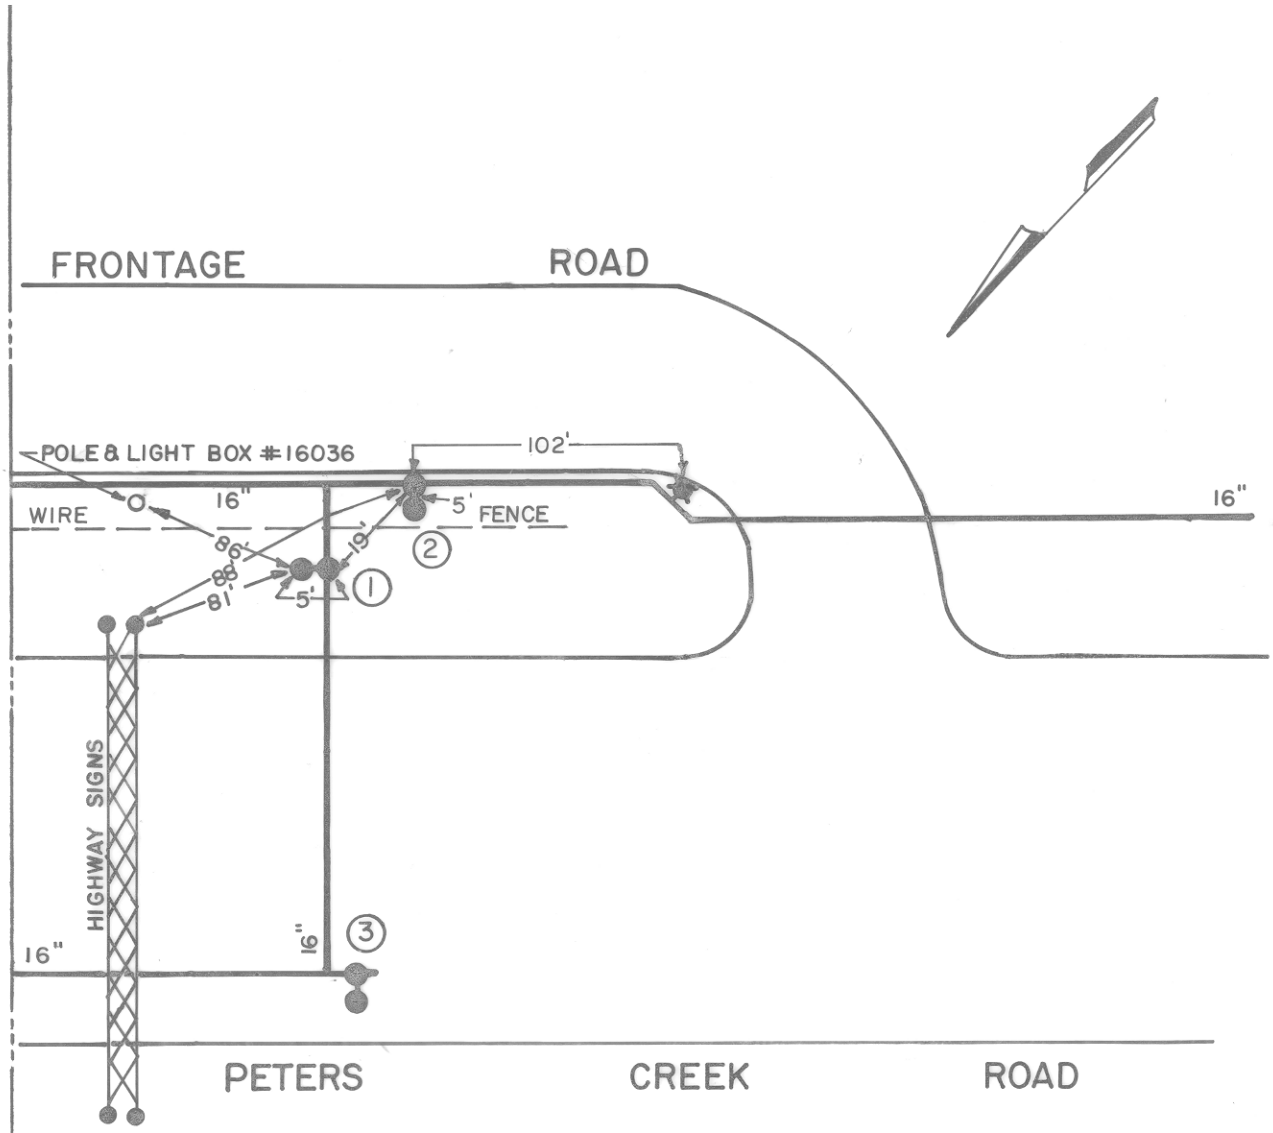

DATE	NO.	SIZE	MAKE	OPEN	TURNS
1976	1	16"	MUELLER	R	
1976	2	16"	MUELLER	R	
1976	3	16"	MUELLER	R	

CITY OF ROANOKE—WATER DEP'T

VALVE DIAGRAM

FRONTAGE ROAD &

PETERS CREEK ROAD

N.W.

SEC. MAP 649, COUNTY # 79

DATE PAGE NO.

11/90NP