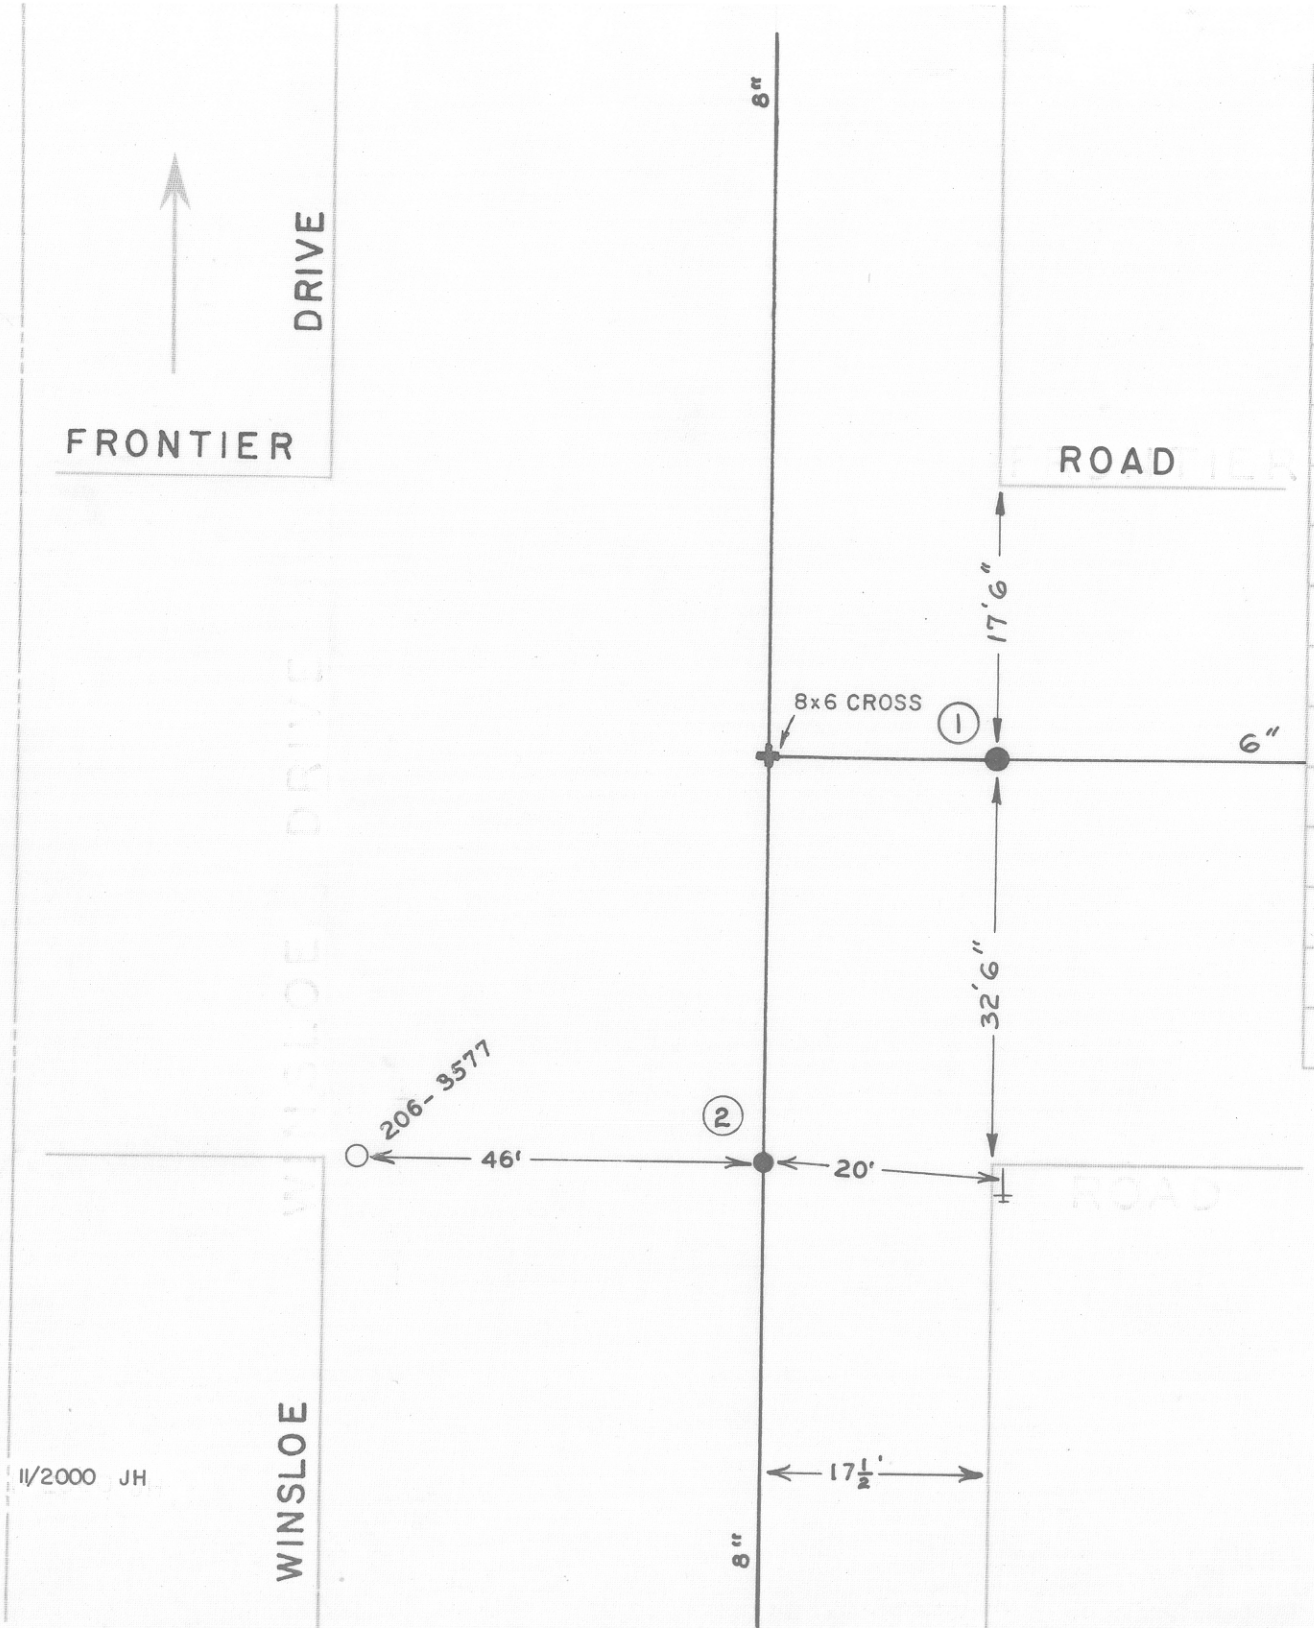

DATE	NO.	SIZE	MAKE	OPEN	TURNS
'59	1	6"	MUELLER	R	20
8-64	2	8"	MUELLER	R	
	1	0	EPL		
	2	0	S.P.L.		

CITY OF ROANOKE—WATER DEP'T

VALVE DIAGRAM

FRONTIER ROAD &

WINSLOE DR. N.W.

SEC. MAP 210 217 N.W.

DATE PAGE NO.

11/2000 JH