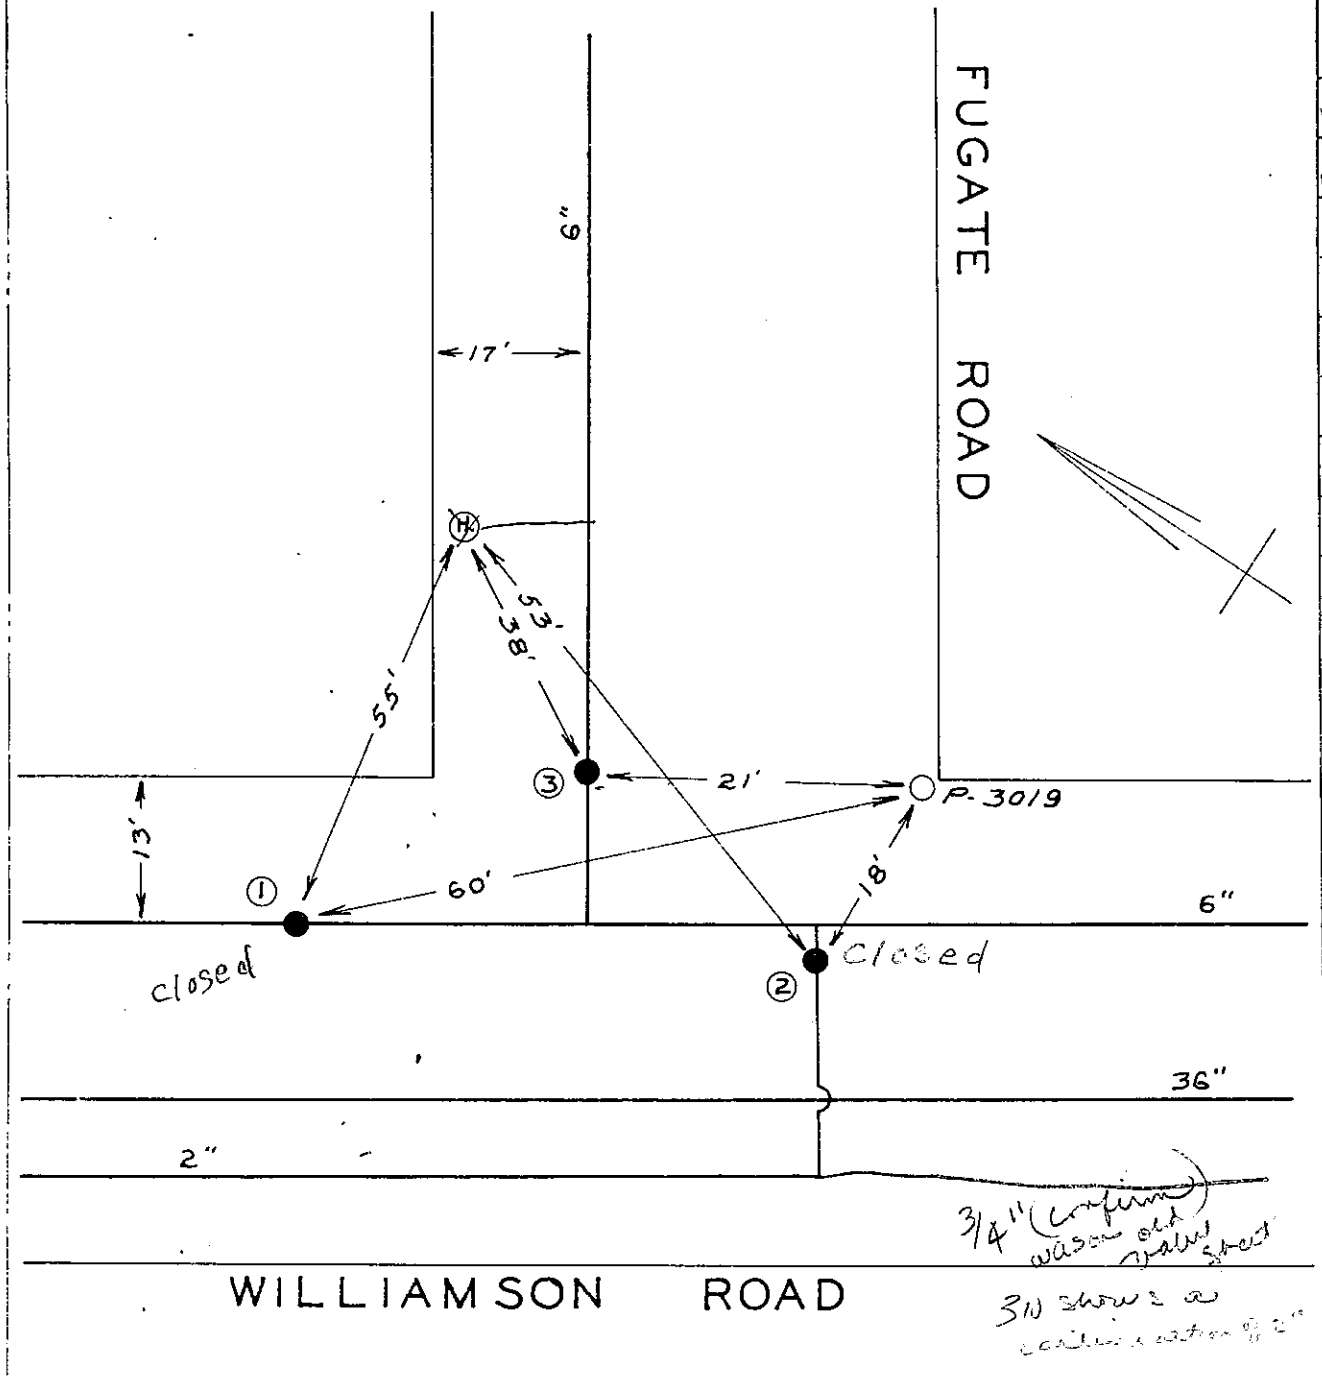

DATE	NO.	SIZE	MAKE	OPEN	TURNS
W.R.	1	6"			
W.R.	2	2"			
1953	3	6"	MUELLER	R	20
	1	23'N	NPL		
	2	15'N	SPL		
	3	0	EPL		

CITY OF ROANOKE—WATER DEPT.

VALVE DIAGRAM

FUGATE RD. & WILLIAMSON RD. N.W. OR N.E.

SEC. MAP 207 — 310

DATE PAGE NO.