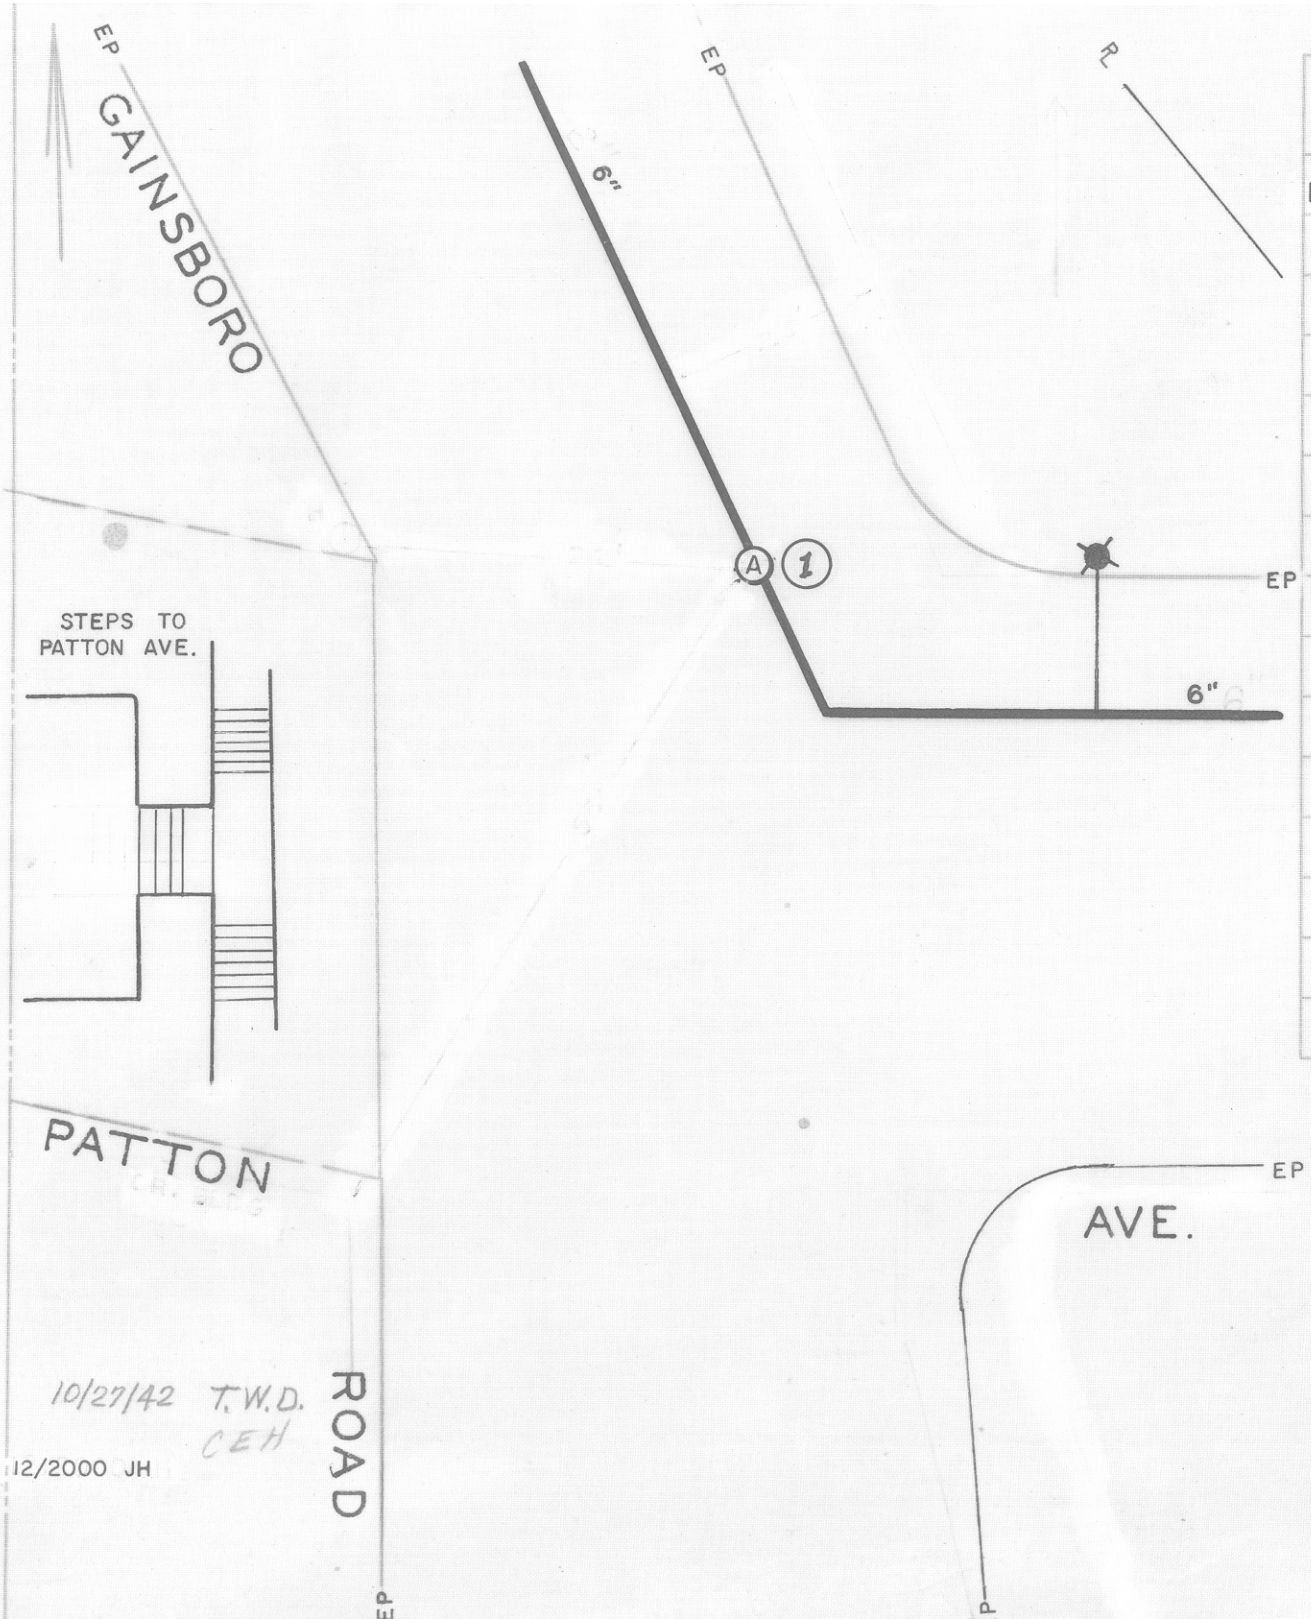

DATE	NO.	SIZE	MAKE	OPEN	TURNS
1997	1	6"	AIR RELIEF VALVE	R	

CITY OF ROANOKE—WATER DEP'T

VALVE DIAGRAM

GAINSBORO ROAD &

PATTON AVE. N.W.

SEC. MAP 201

DATE

PAGE NO NW.24