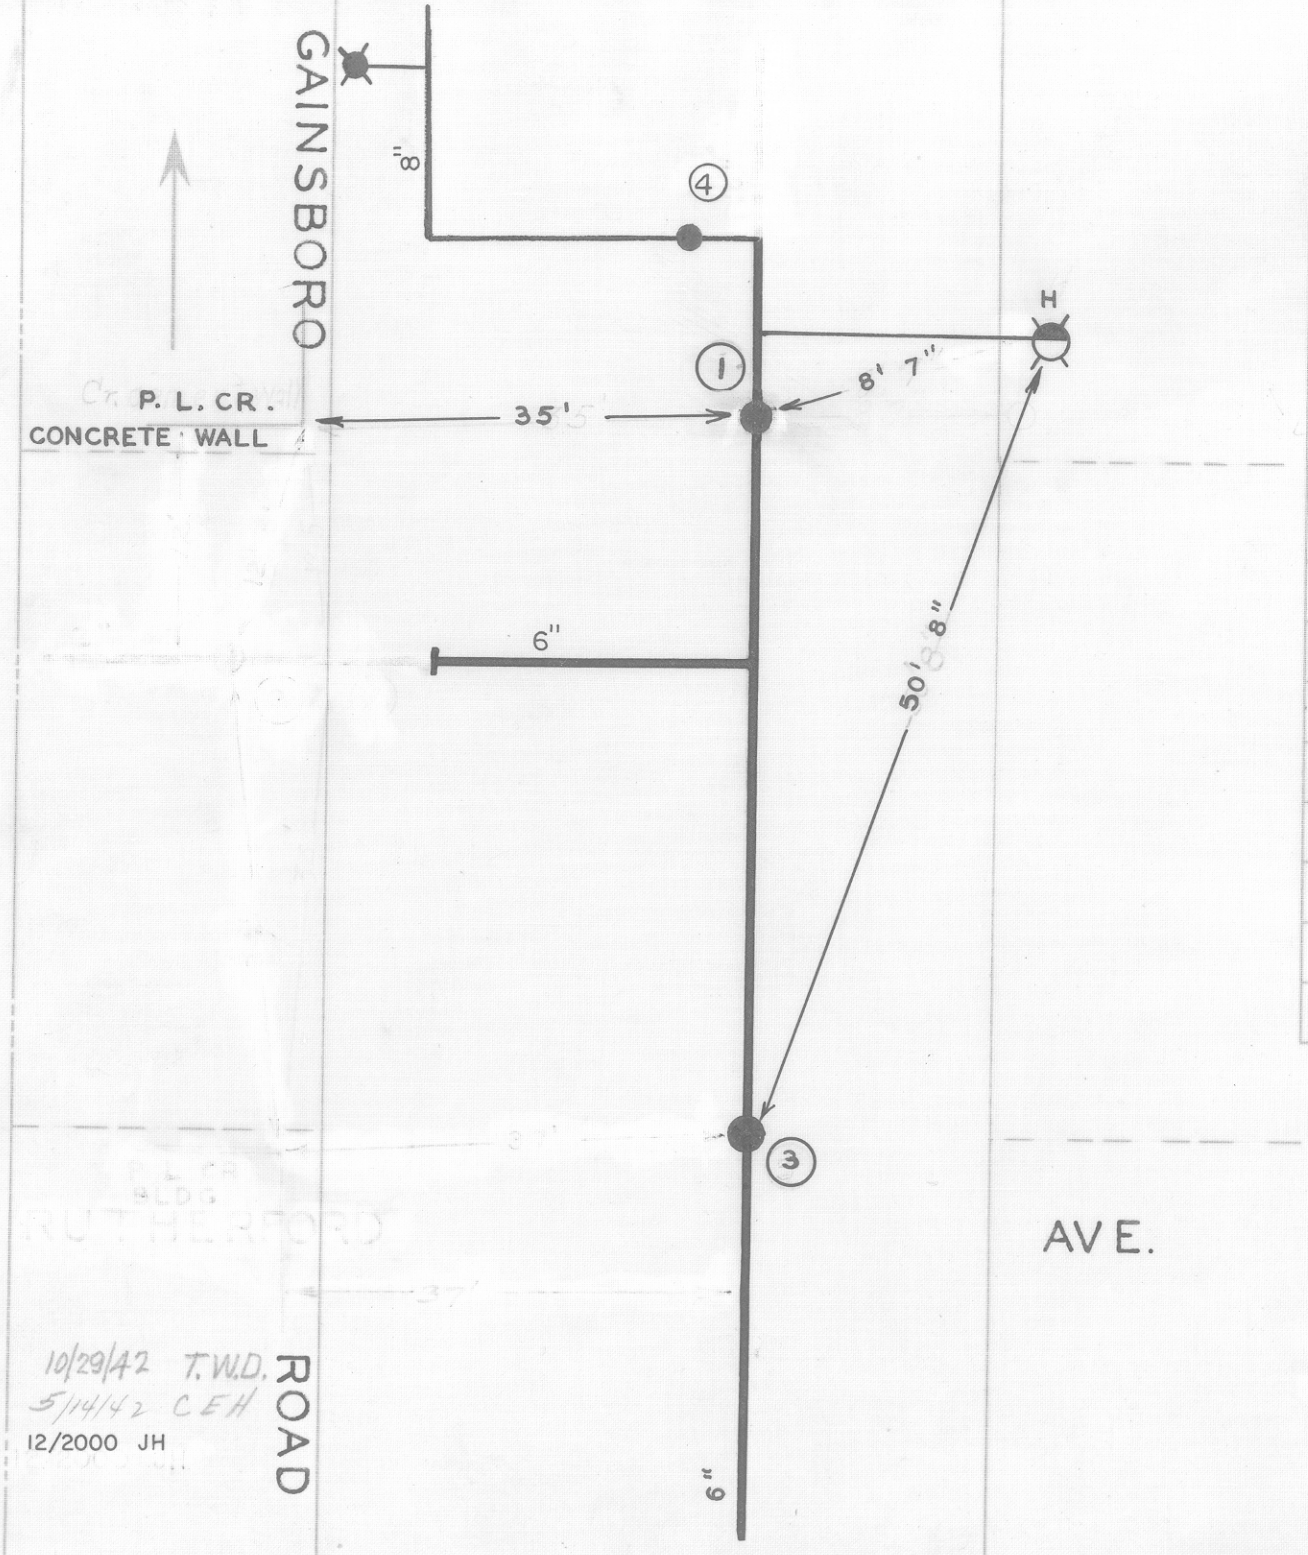

DATE	NO.	SIZE	MAKE	OPEN	TURNS
1892	1	6"		R	20 1/2
~~1901~~	~~2~~	~~2"~~		~~R~~	~~14~~
1892	3	6"		R	13
	4	8"			
	1	0	NPL		
	~~2~~	~~3'W~~	~~WPL~~		
	3	0	SPL		

10/29/42 T.W.D.
5/14/42 CEH
12/2000 JH

CITY OF ROANOKE—WATER DEP'T
VALVE DIAGRAM
GAINSBORO RD. 600 BLOCK
N. OF HARRISON

SEC. MAP 202
DATE
PAGE NO. NW.35