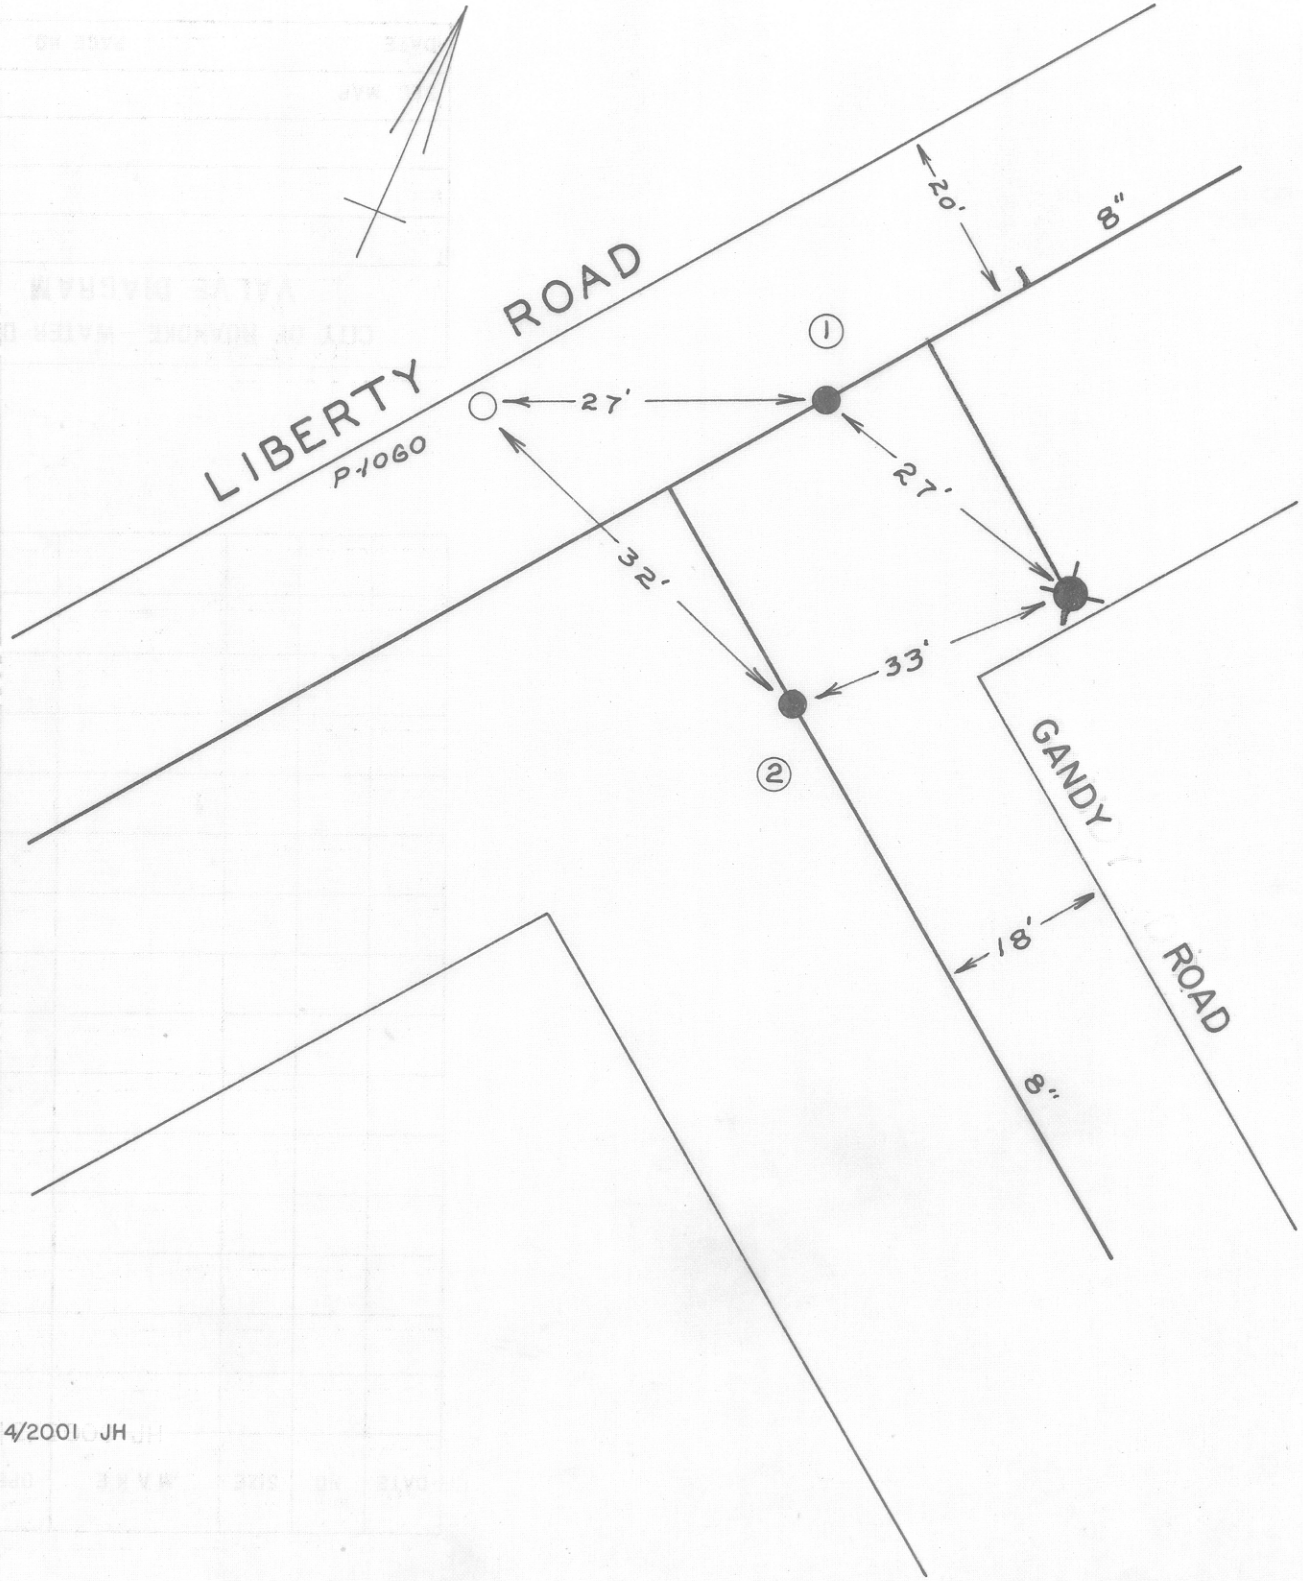


| DATE | NO. | SIZE | MAKE | OPEN | TURNS |
|---|---|---|---|---|---|
| 1952 | 1 | 8" | | | |
| 1952 | 2 | 8" | | | |
| | | | | | |
| | | | | | |
| | | | | | |
| | | | | | |
| | | | | | |
| | | | | | |
| | | | | | |
| | | | | | |
| | | | | | |
| | 1 | 0 | NPL | | |
| | 2 | 7'-W | EPL | | |
| | | | | | |
| | | | | | |

CITY OF ROANOKE—WATER DEPT.

VALVE DIAGRAM

GANDY ROAD & LIBERTY ROAD

SEC. MAP 204 N.W.

DATE PAGE NO.

4/2001 JH

"IMPERIAL" TRACING CLOTH K & E CO., N.Y.