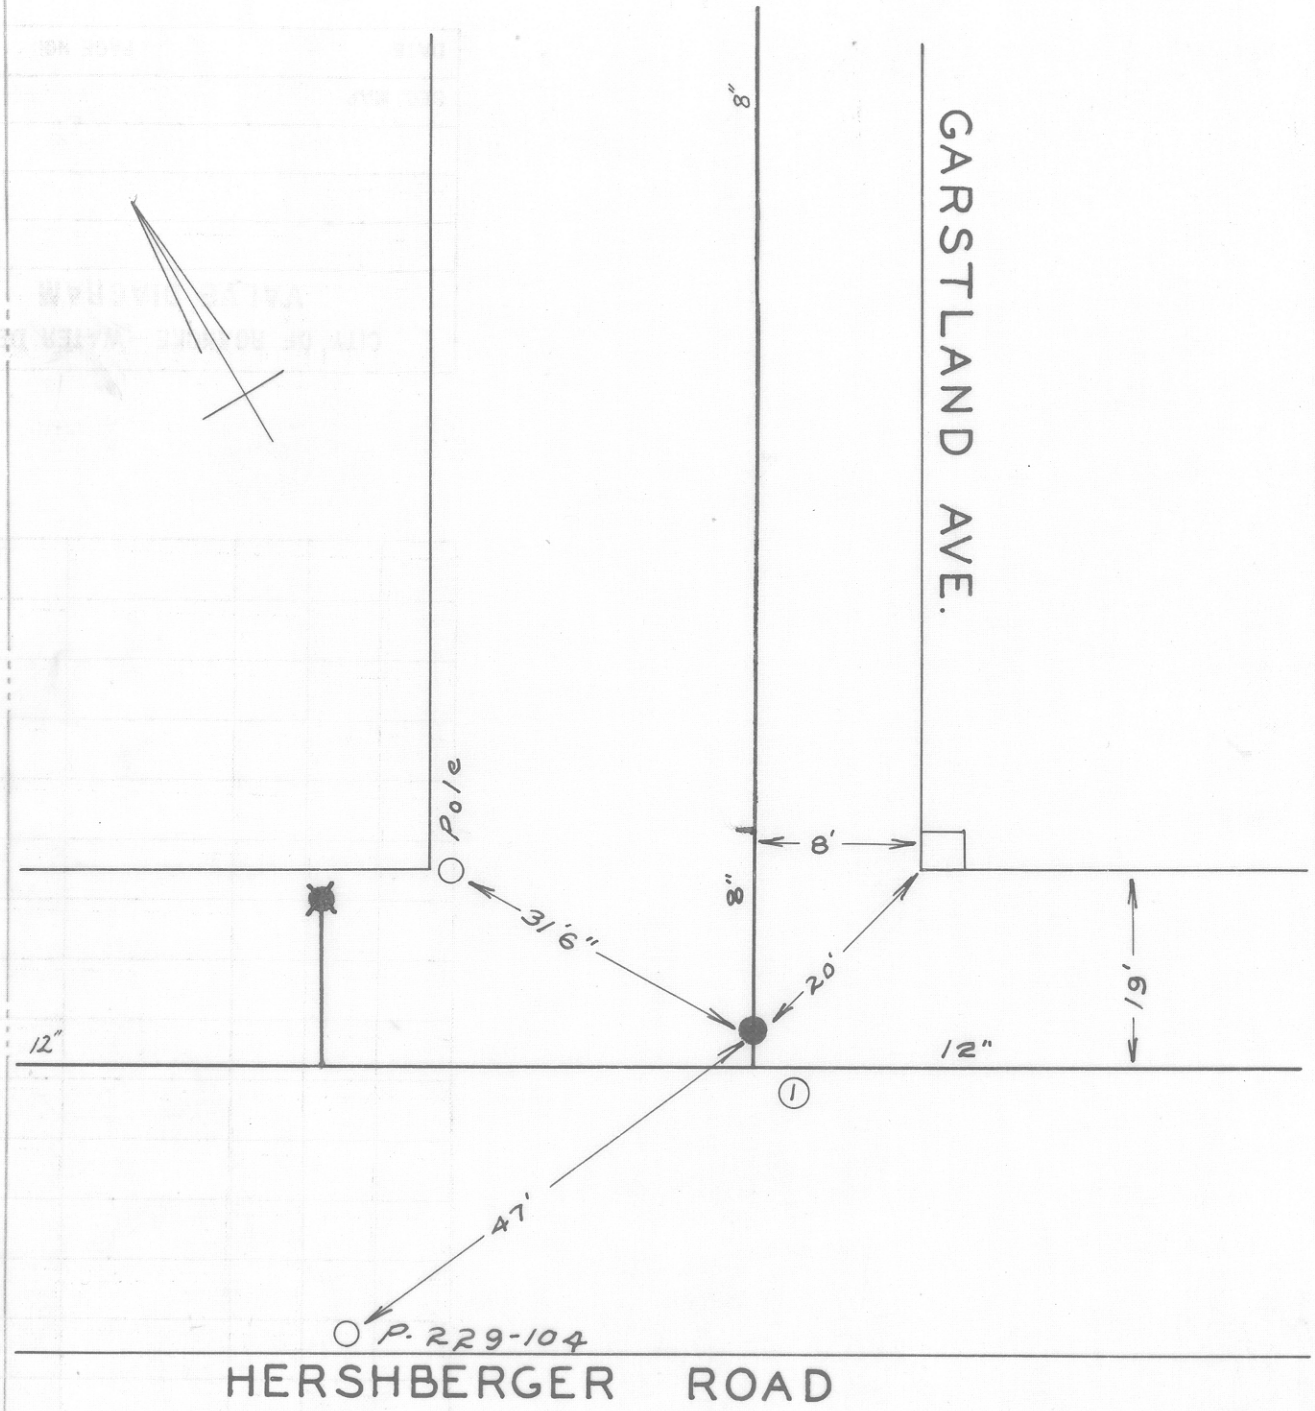

12/2000 JH

DATE	NO.	SIZE	MAKE	OPEN	TURNS
1952	1	8"	DARLING	R	
	1	19'-S	NPL		

CITY OF ROANOKE — WATER DEPT.

VALVE DIAGRAM

GARSTLAND AVE. &

HERSHBERGER RD. N.W.

SEC. MAP 638 N.W.

DATE PAGE NO.

"IMPERIAL" TRACING CLOTH K & E CO., N. Y.