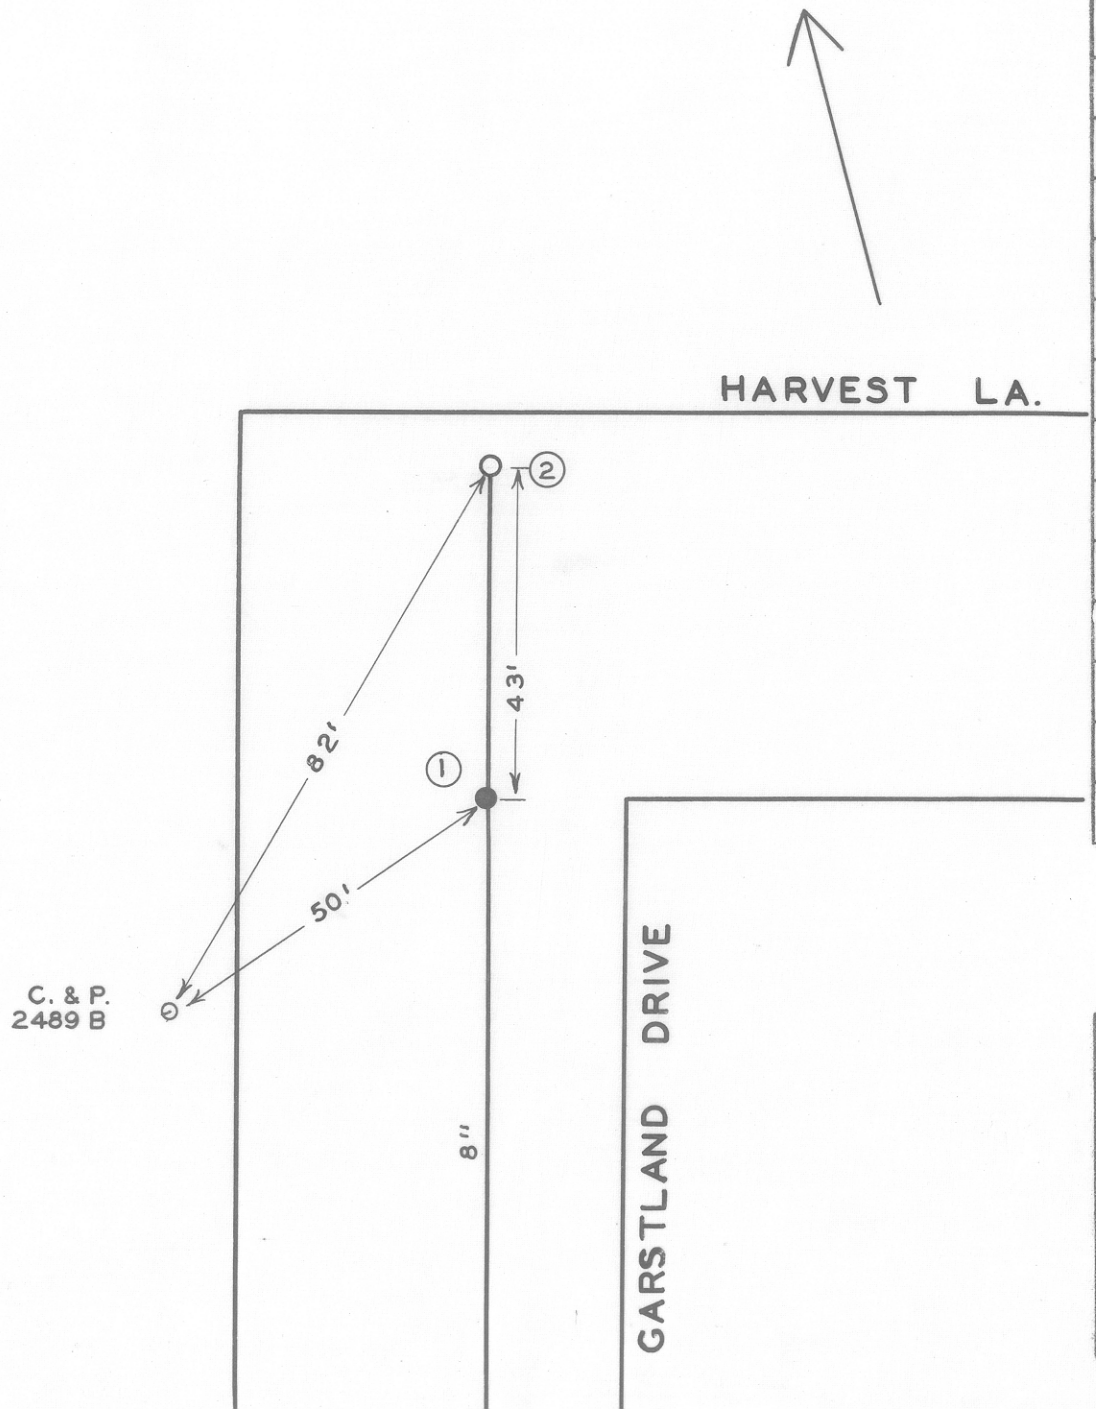

DATE	NO.	SIZE	MAKE	OPEN	TURNS
12-62	1	8"	MUELLER	R	27
12-62	2	2"	MISC.		
	1	0	S.P.L.		

CITY OF ROANOKE — WATER DEPT.

VALVE DIAGRAM

GARSTLAND DRIVE &
HARVEST LANE

SEC. MAP 638 N.W.

DATE PAGE NO.

12/2000 JH