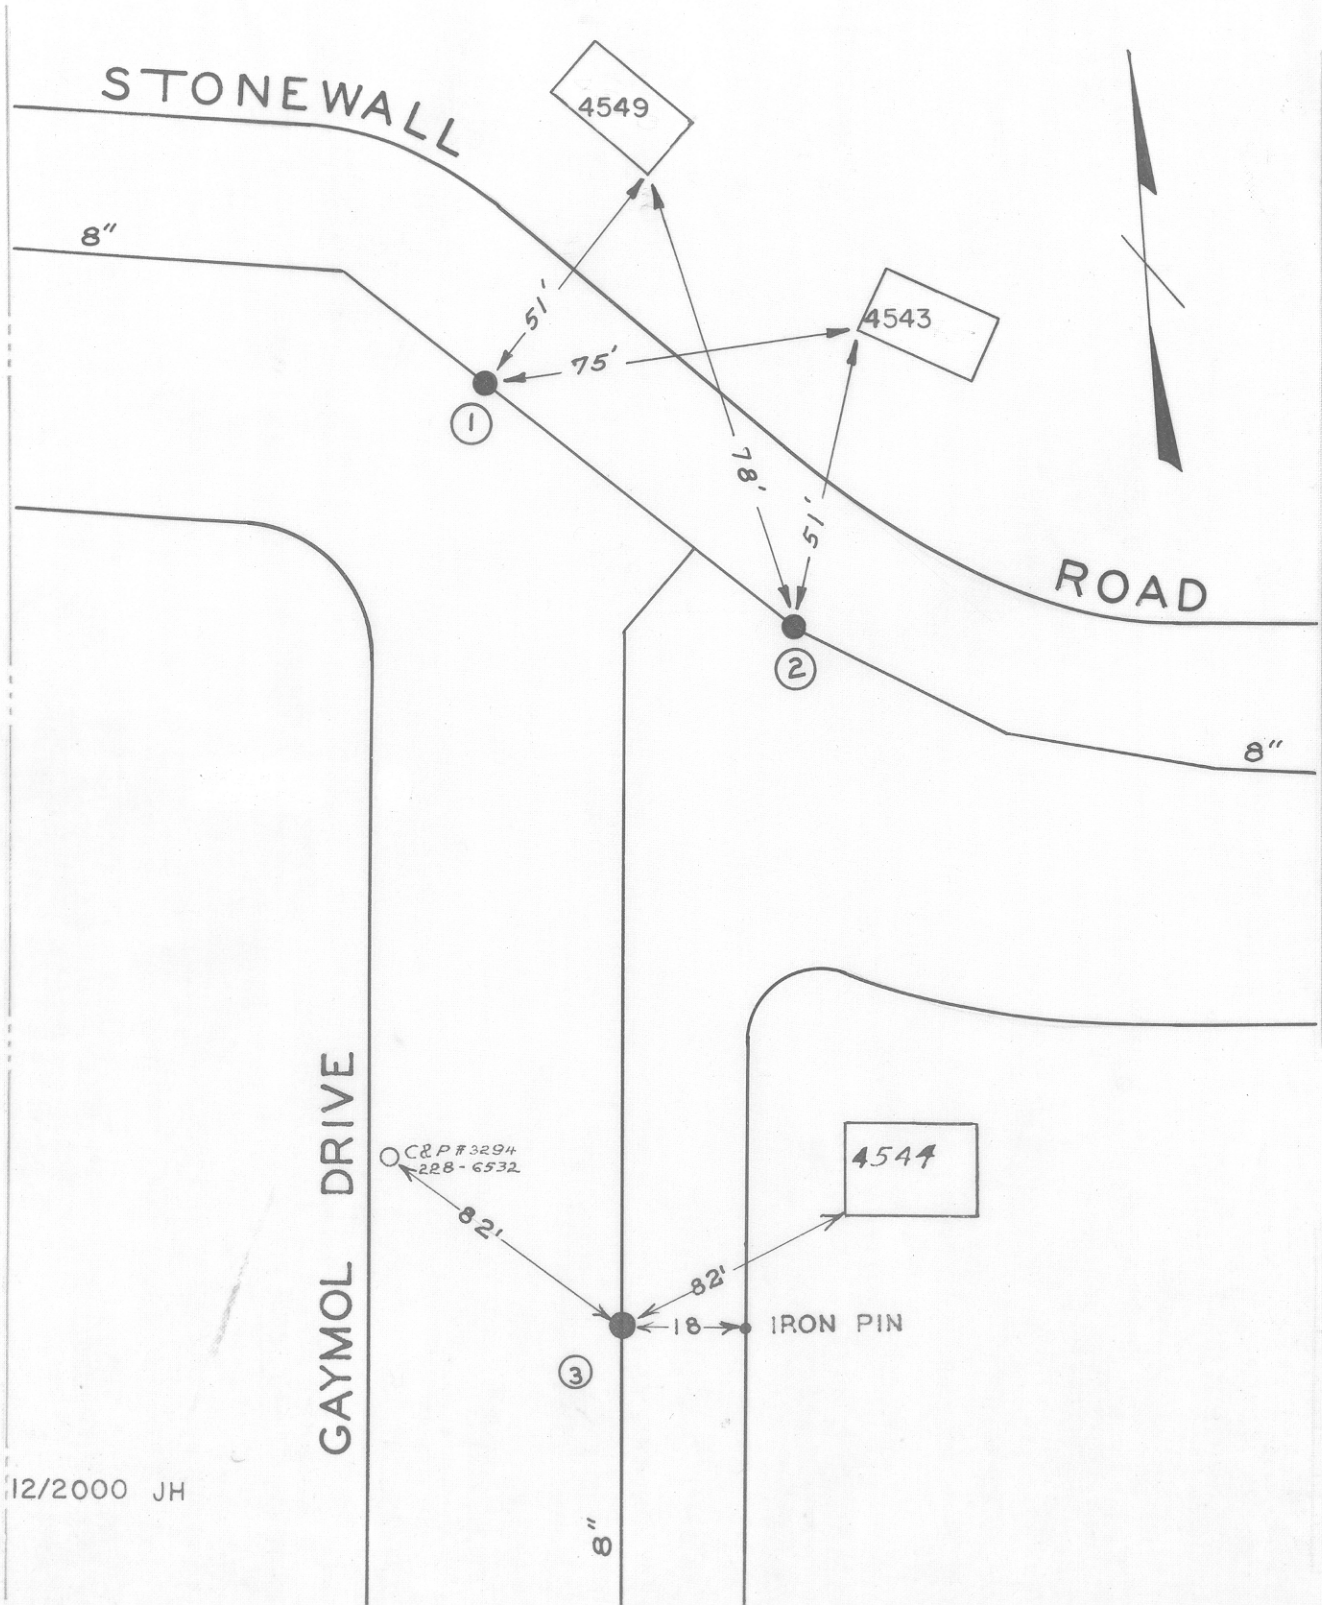

DATE	NO.	SIZE	MAKE	OPEN	TURNS
'58	1	8"	MUELLER	R	26½
'58	2	8"	MUELLER	R	26½
4-62	3	8"	DARLING	R	21
	1	9'-E	WPL		
	2	3'-E	EPL		

CITY OF ROANOKE—WATER DEPT.

VALVE DIAGRAM

GAYMOL DRIVE & STONEWALL ROAD

N.W. AT UNNAMED ST.

SEC. MAP 607 N. W.

DATE PAGE NO.

12/2000 JH

"IMPERIAL" TRACING CLOTH K & E CO., N.Y.