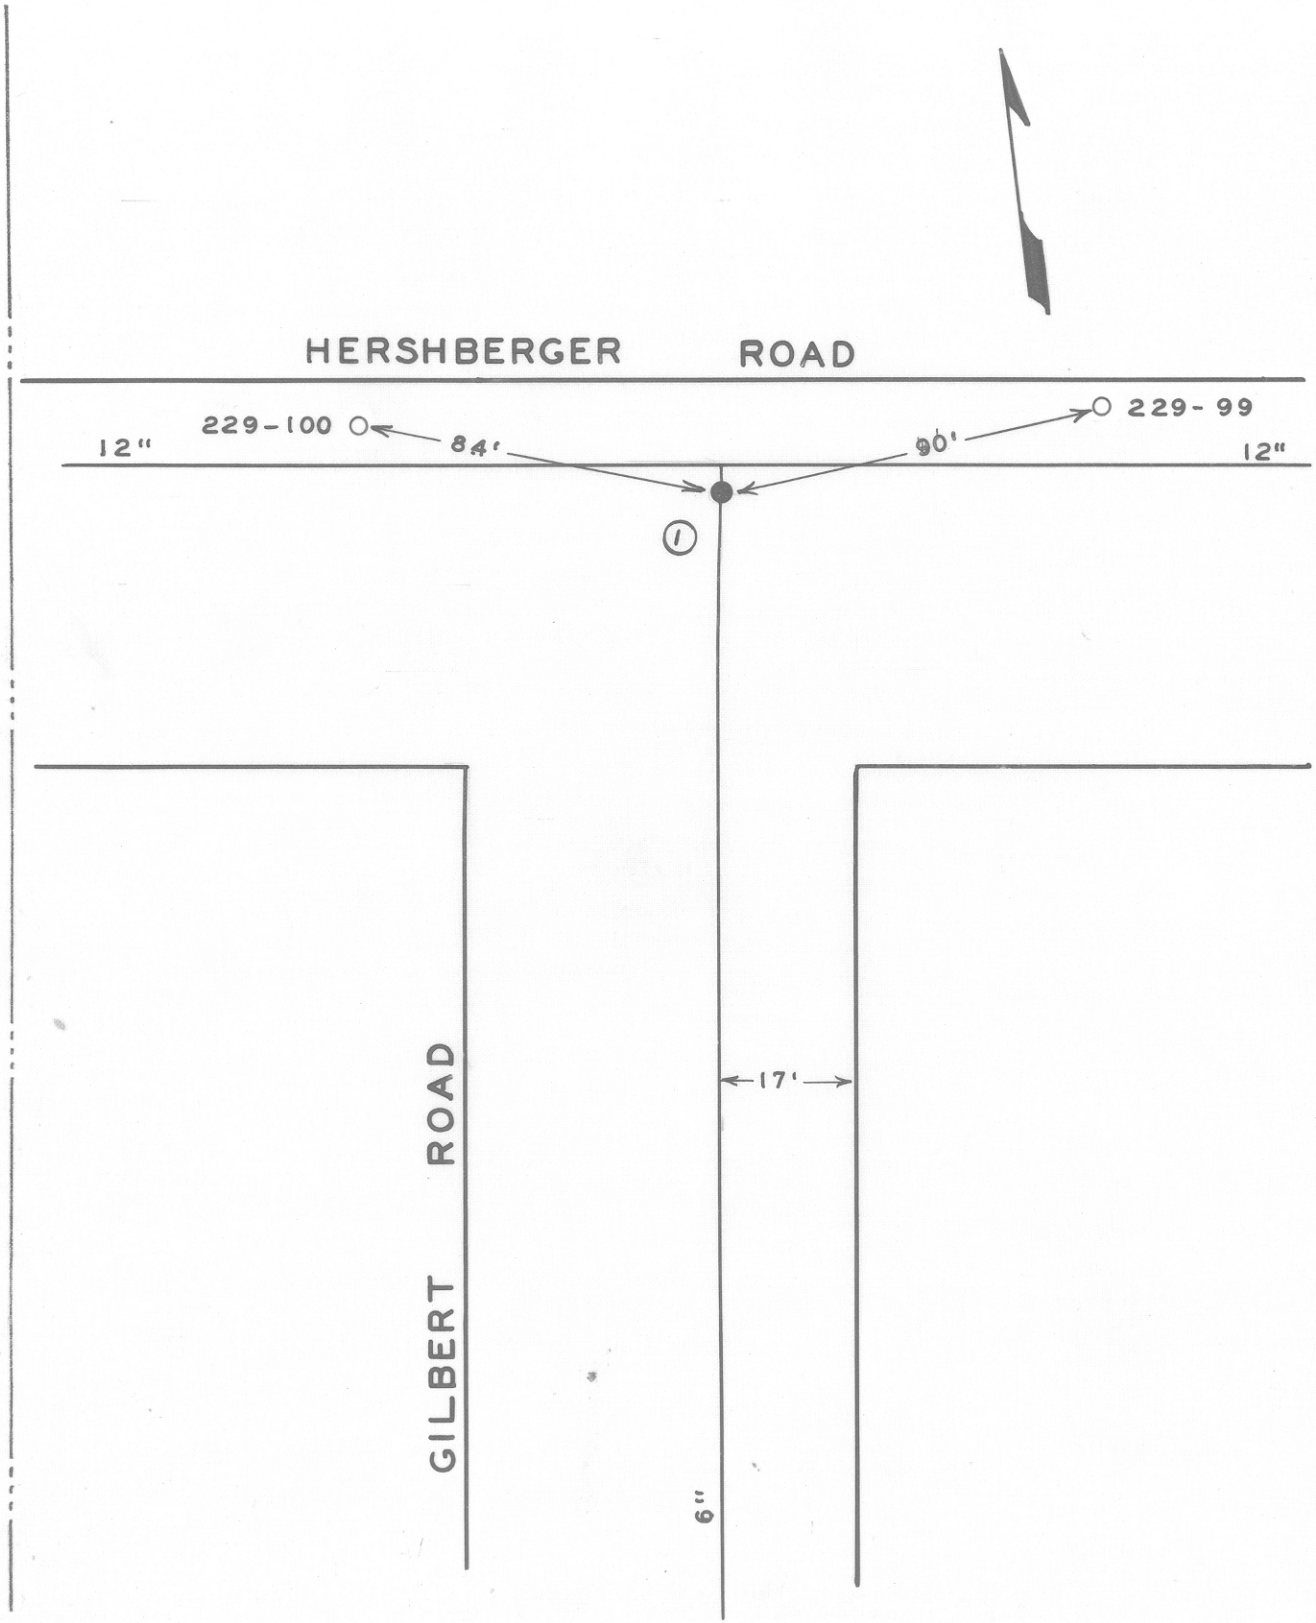

DATE	NO.	SIZE	MAKE	OPEN	TURNS
12-63	1	6"	DARLING	R	
	1	15'S	N.P.L		

CITY OF ROANOKE—WATER DEPT.

VALVE DIAGRAM

GILBERT ROAD &

HERSHBERGER ROAD N.W.

SEC. MAP 267

DATE PAGE NO.