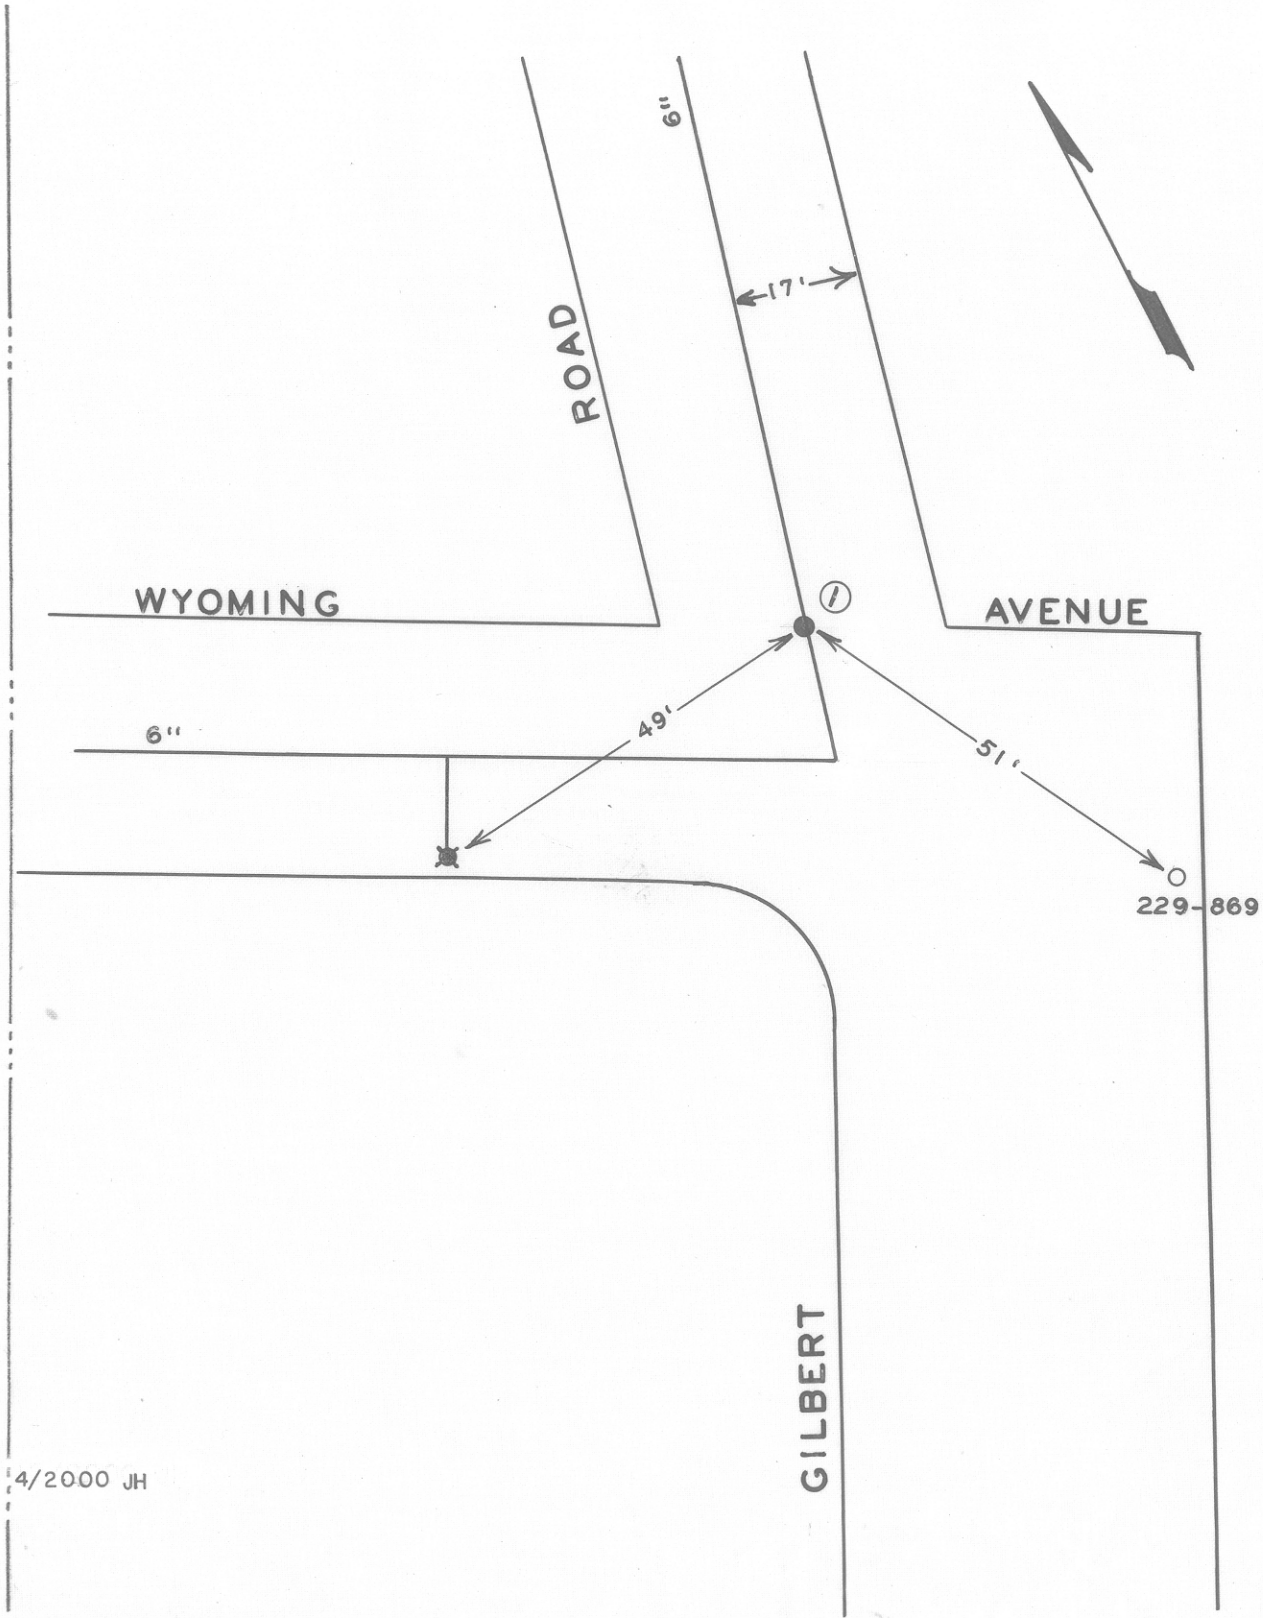

DATE	NO.	SIZE	MAKE	OPEN	TURNS
12-63	1	6"	MUELLER	R	
	1	0	N.P.L.		

CITY OF ROANOKE—WATER DEPT.

VALVE DIAGRAM

GILBERT ROAD &

WYOMING AVENUE

SEC. MAP 267 N.W.

DATE PAGE NO.