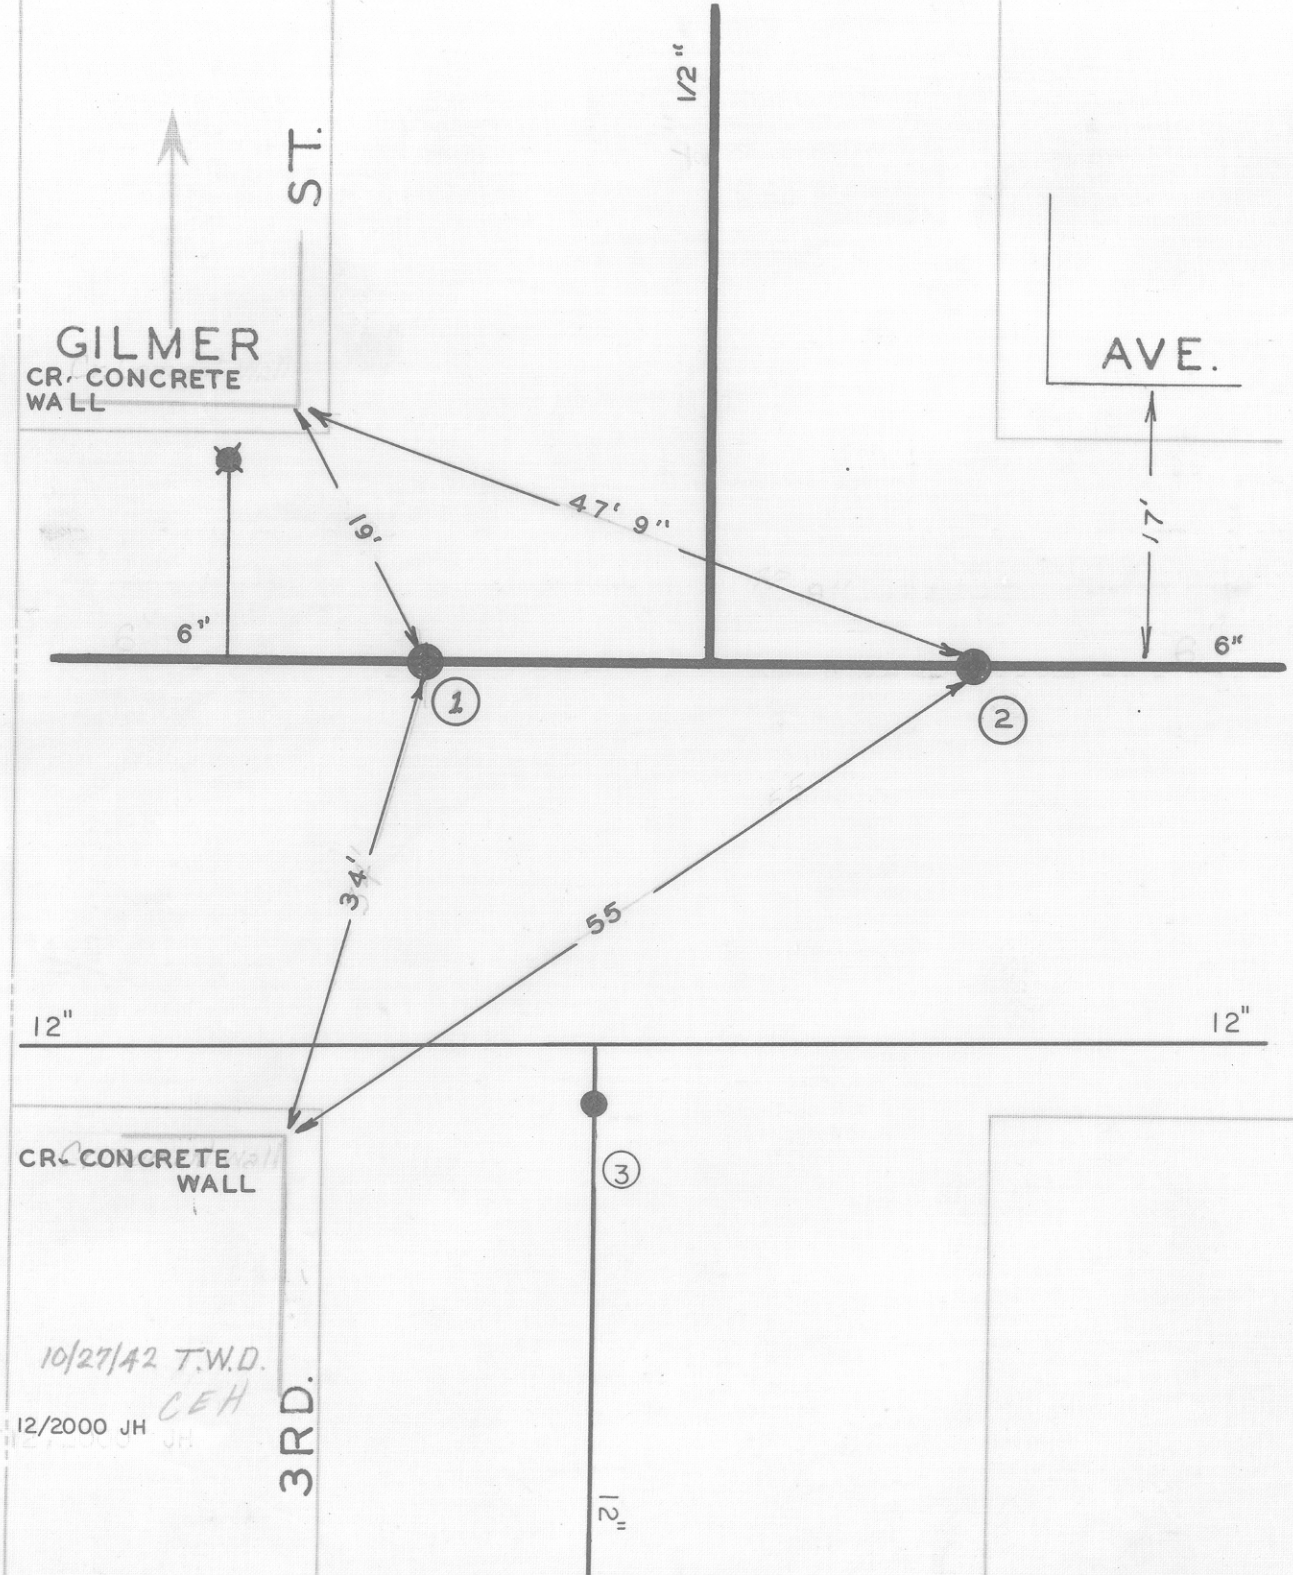

DATE	NO.	SIZE	MAKE	OPEN	TURNS
1893	1	6"		R	19 1/2
1902	2	6"		R	19
1984	3	12"		R	
	1	9'-E	WPL		
	2	6'-W	EPL		

CITY OF ROANOKE—WATER DEP'T

VALVE DIAGRAM

GILMER AVE. & 3rd. STREET

SEC. MAP 201 N.W.

DATE PAGE NO. N.W. 20