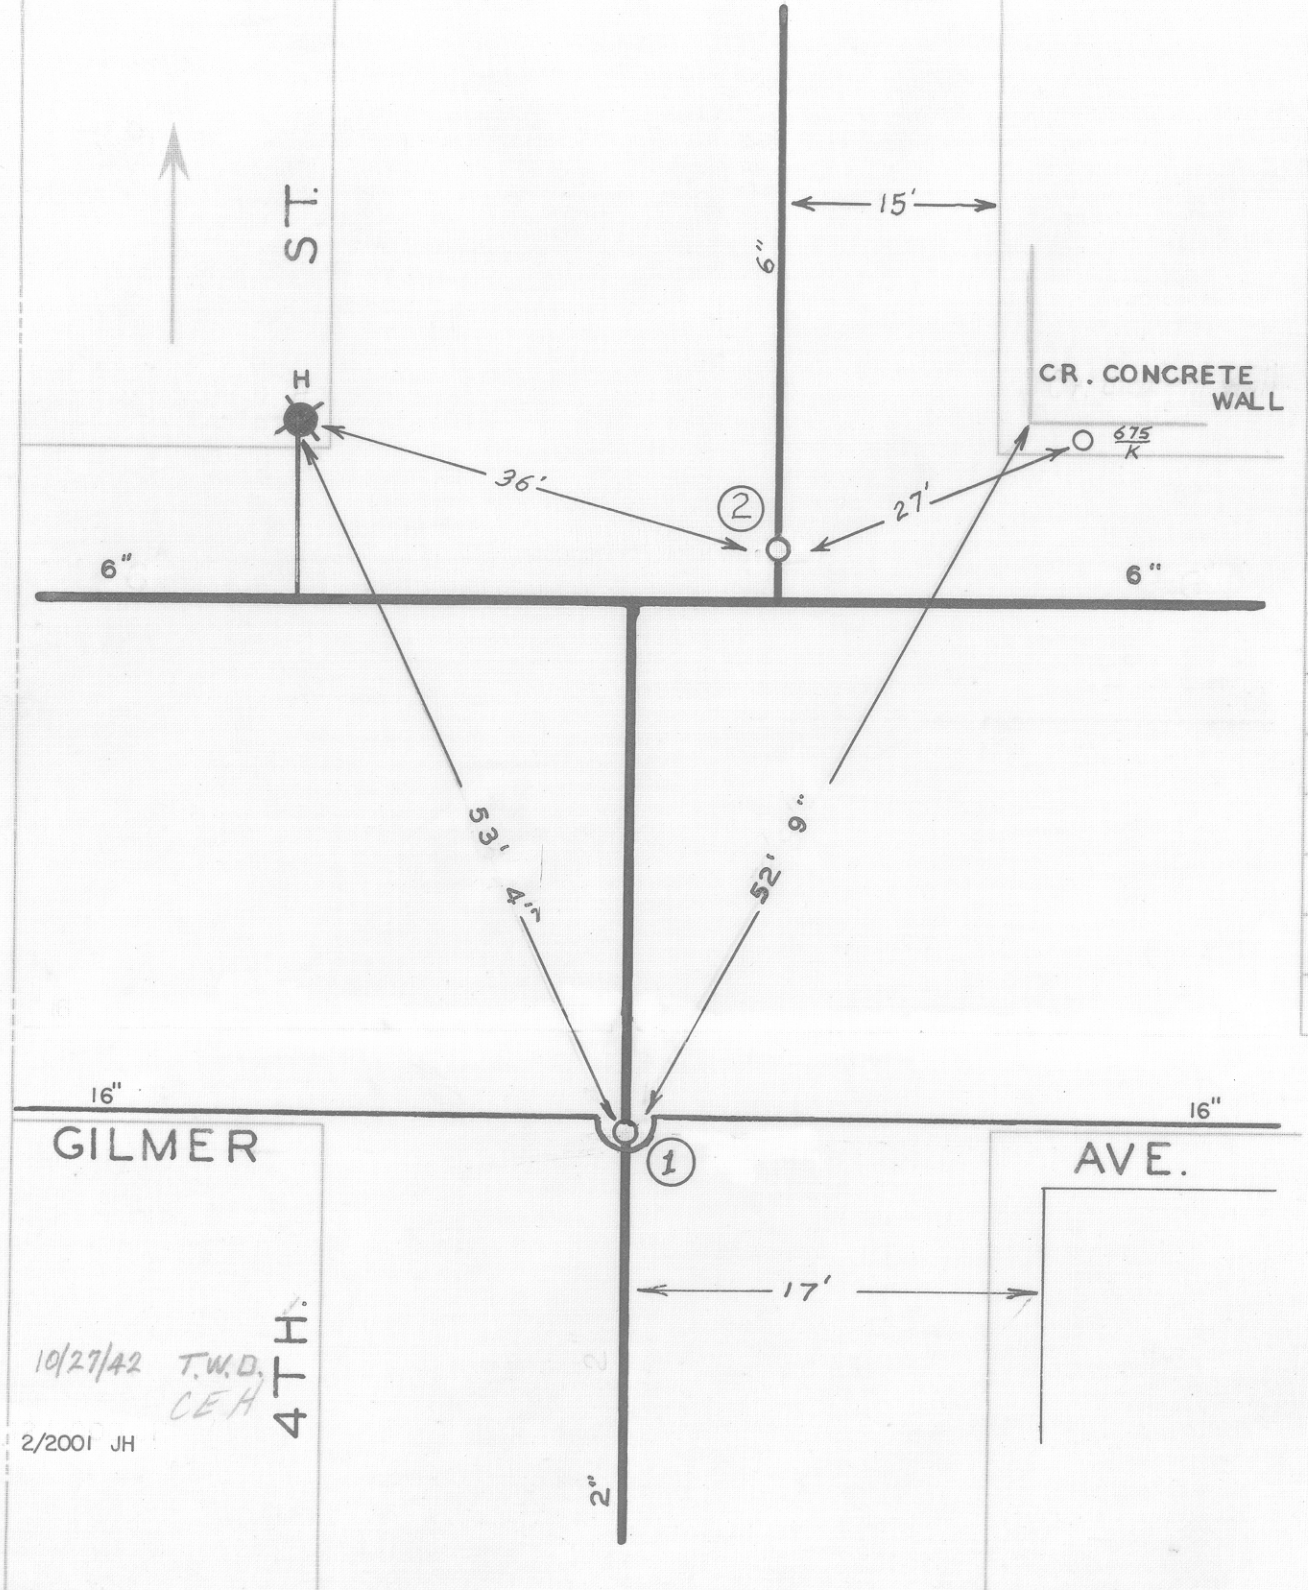

DATE	NO.	SIZE	MAKE	OPEN	TURNS
1893	1	2"		R	6
1969	2	6"	MUELLER	R	
	1	0	SPL		
	2	16-S	NPL		

CITY OF ROANOKE—WATER DEP'T

VALVE DIAGRAM

GILMER AVE. &

4TH STREET

SEC. MAP 201 N.W.

DATE PAGE NO. N.W. 21