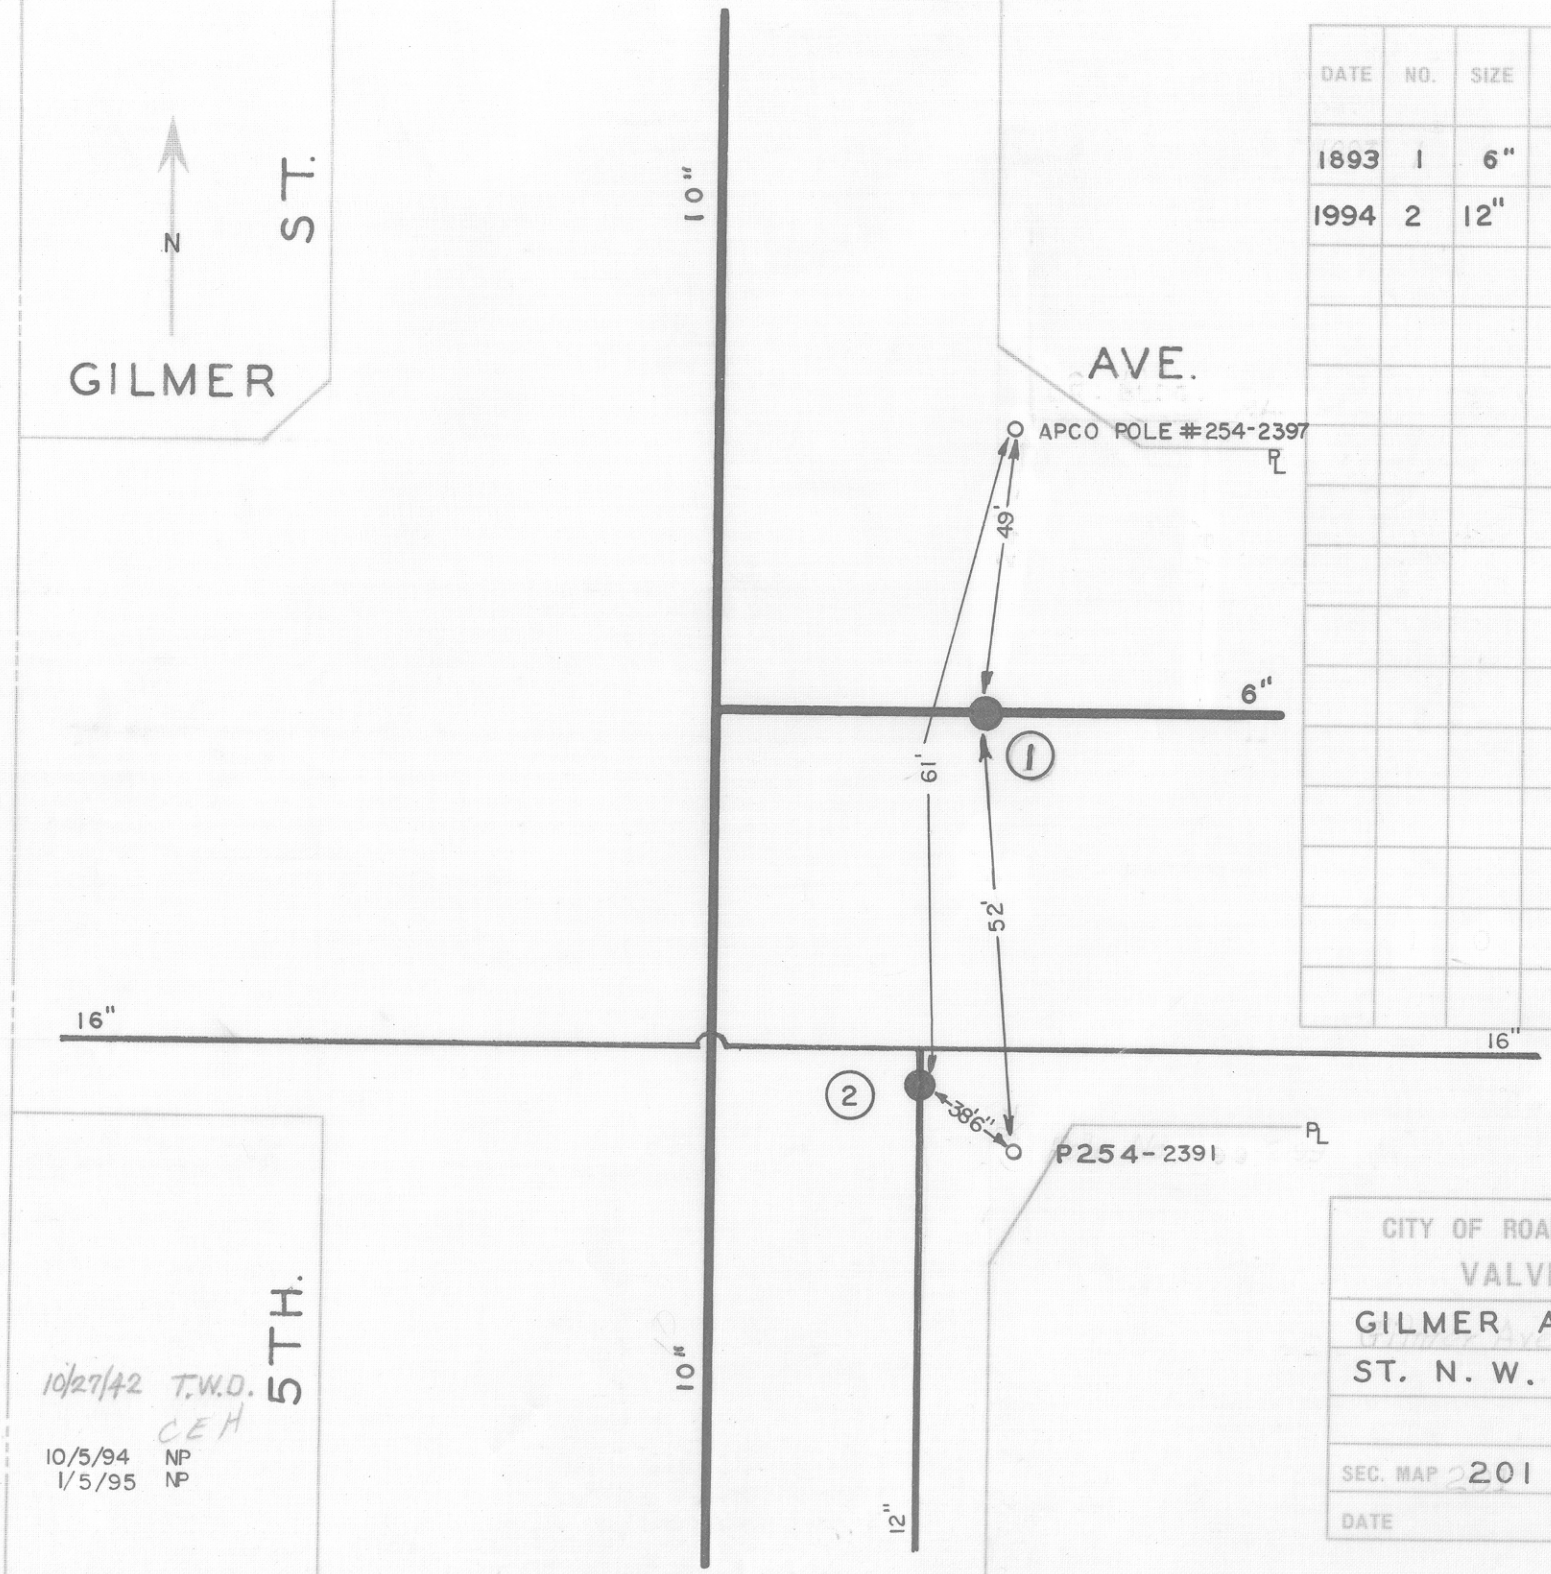

DATE	NO.	SIZE	MAKE	OPEN	TURNS
1893	1	6"		R	22
1994	2	12"		R	38

10/27/42 T.W.D.
CEH
10/5/94 NP
1/5/95 NP

CITY OF ROANOKE—WATER DEP'T
VALVE DIAGRAM
GILMER AVE. & 5TH. ST. N. W.

SEC. MAP 201
DATE
PAGE NO N.W.22