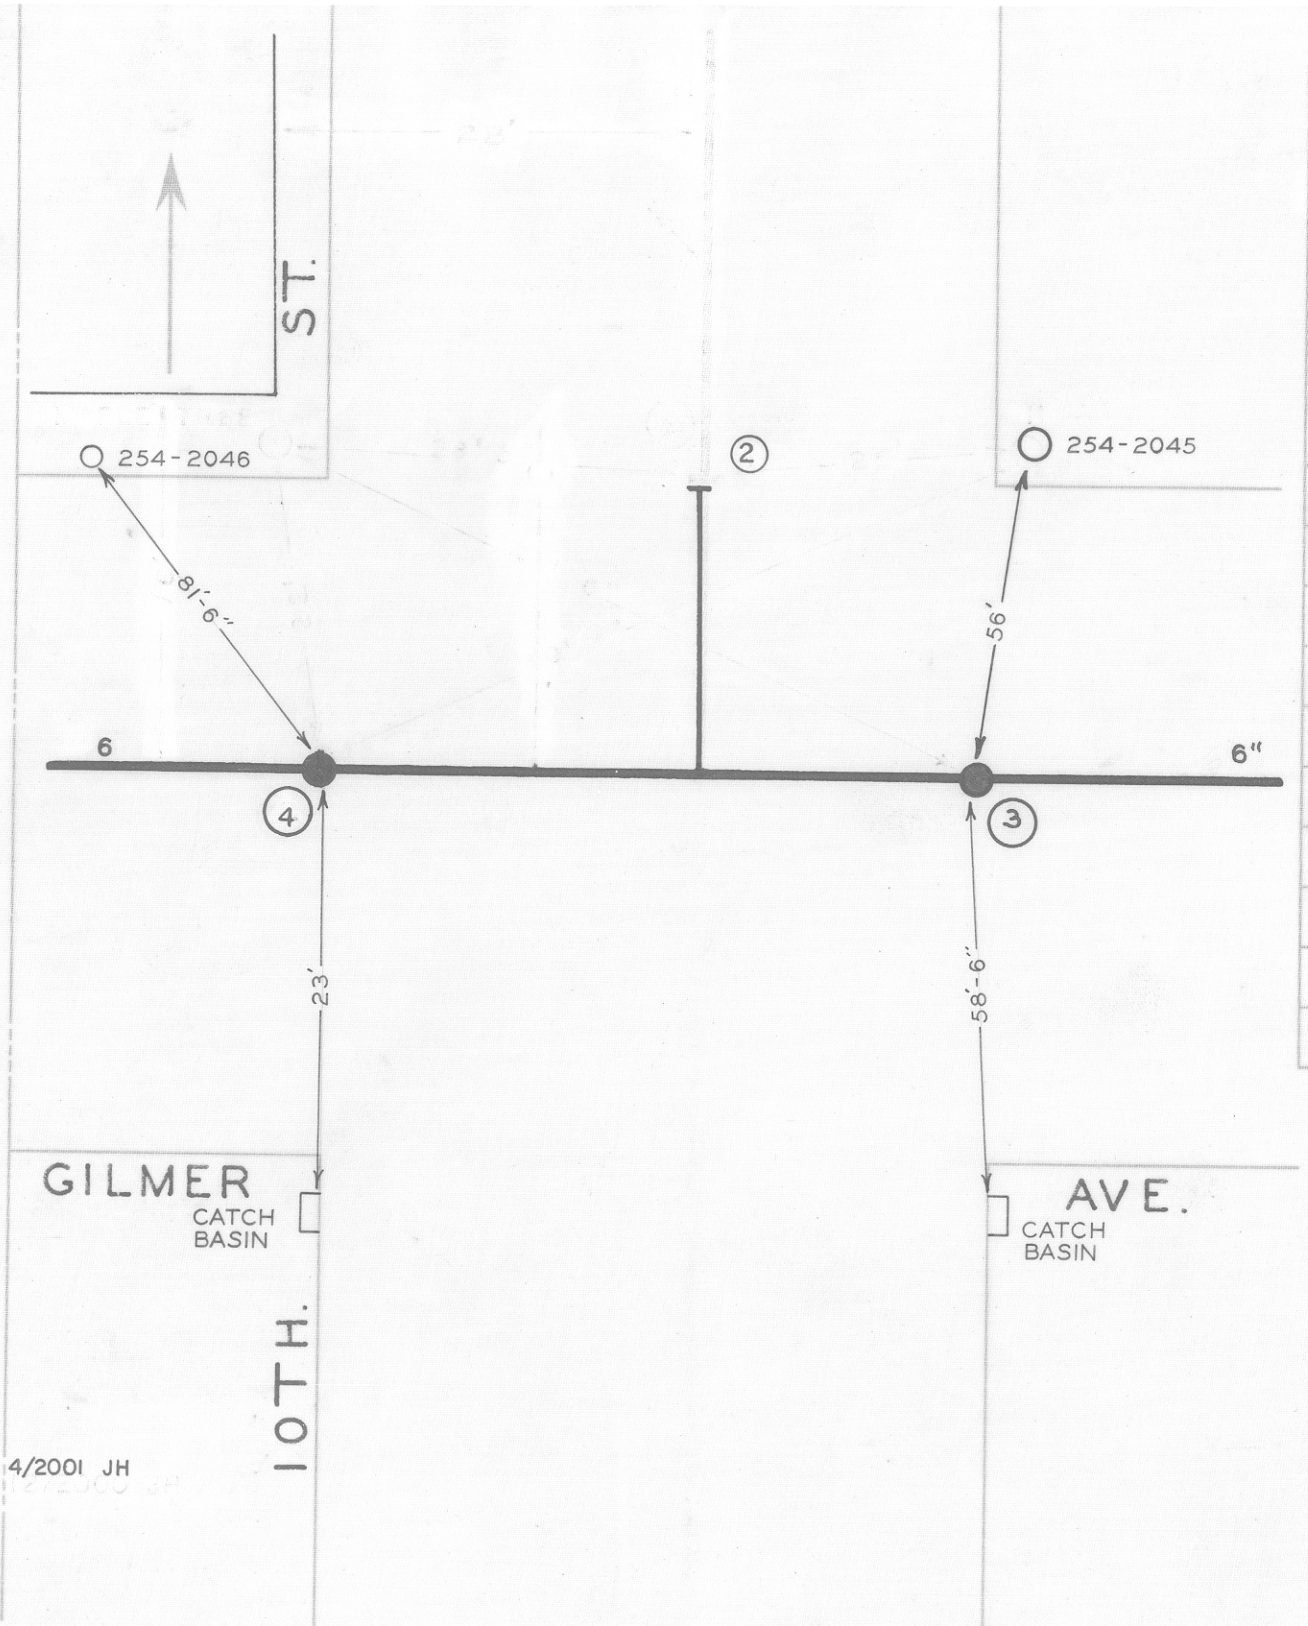

DATE	NO.	SIZE	MAKE	OPEN	TURNS
	1	2		R	6 1/2
1892	2	6"		R	12 1/2
1911	3	6"		R	12
	4	6"		R	
	1	6	IPL		
	2	1 1/2 E	WPL		
	3	12" W	EPL		

4/2001 JH

CITY OF ROANOKE—WATER DEP'T

VALVE DIAGRAM

GILMER AVE. & 10TH.

10 TH. STREET

SEC. MAP 211 N.W.

DATE PAGE NO. N.W. 94