DATE	NO.	SIZE	MAKE	OPEN	TURNS
6/84	1	12"	KENNEDY	R	39

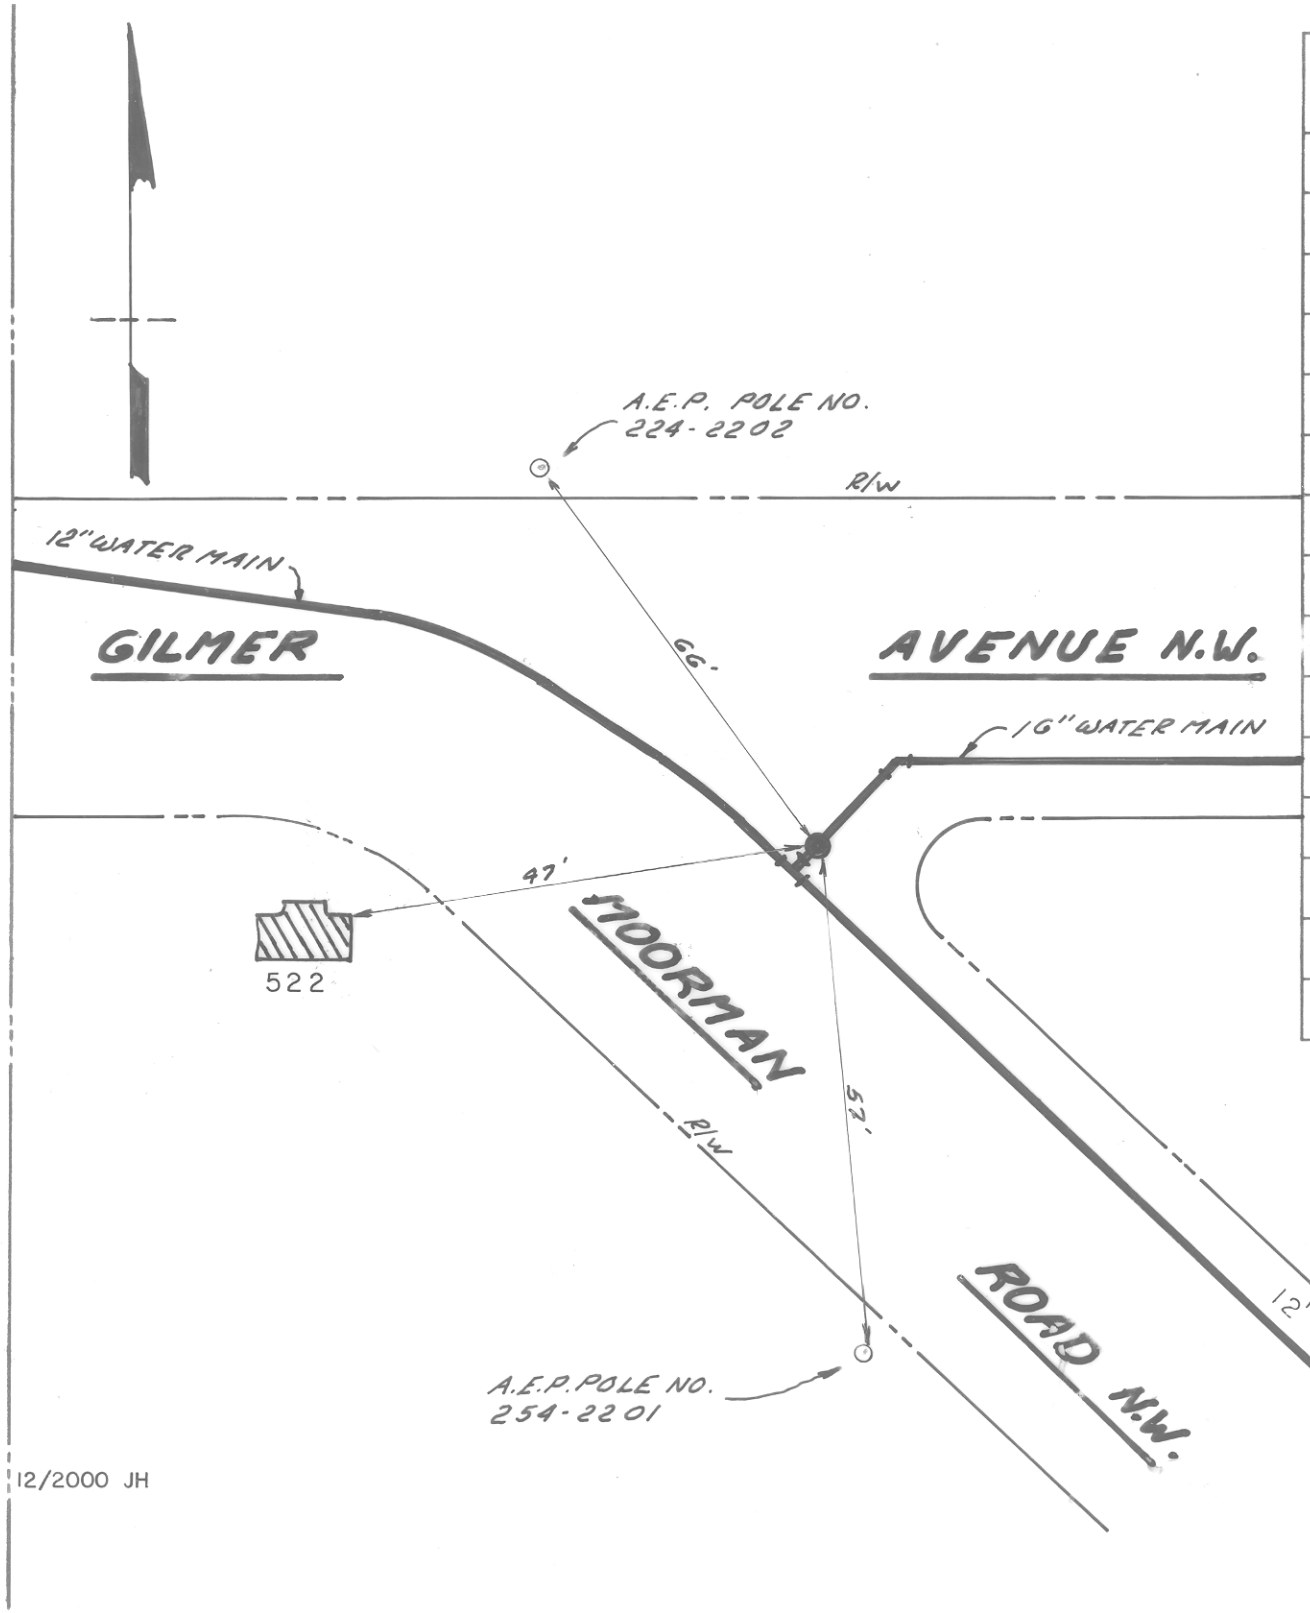

12/2000 JH

CITY OF ROANOKE—WATER DEP'T

VALVE DIAGRAM

GILMER AVENUE

AND

MOORMAN ROAD.

SEC. MAP 201 N.W.

DATE 10-11-84 PAGE NO.