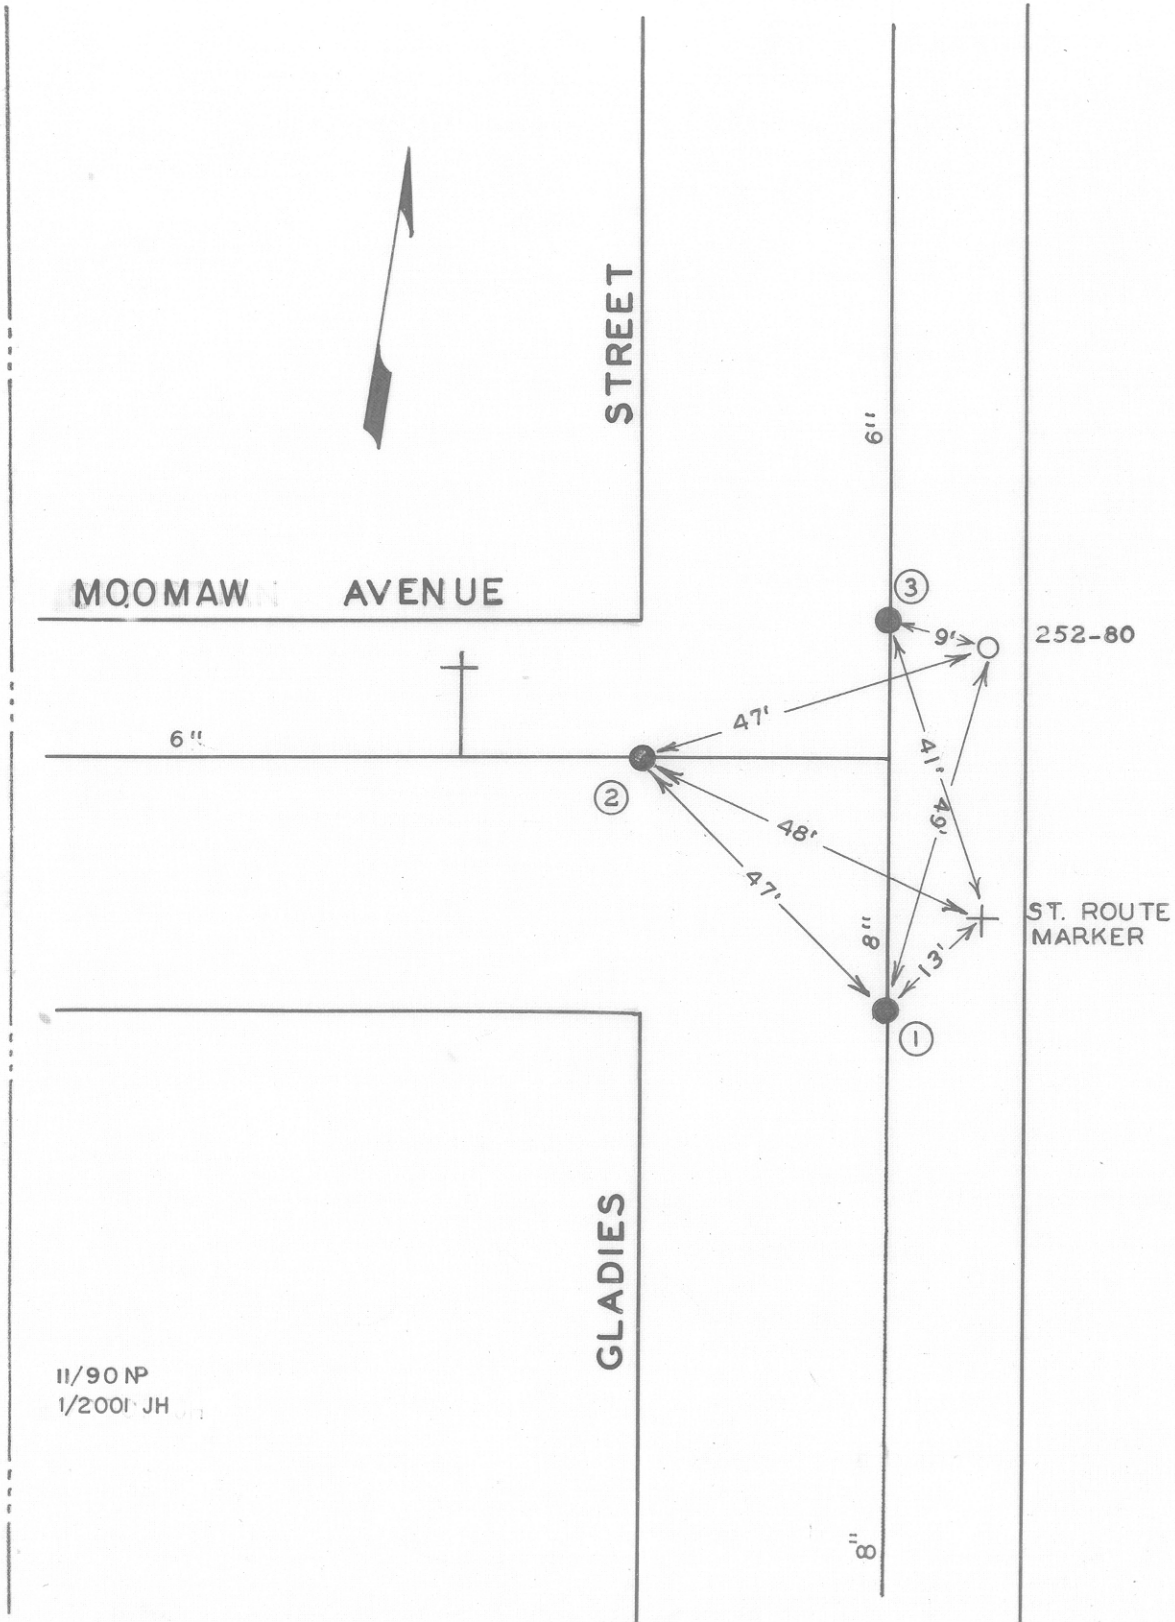

DATE	NO.	SIZE	MAKE	OPEN	TURNS
4-62	1	8"	MUELLER	R	26
4-62	2	6"	MUELLER	R	20
4-62	3	6"	MUELLER	R	20
	1	0	S.P.L.		
	2	0	W.P.L.		
	3	0	N.P.L.		

CITY OF ROANOKE—WATER DEPT.

VALVE DIAGRAM

GLADIES STREET &

MOOMAW AVENUE N.W.

SEC. MAP 605

DATE PAGE NO.