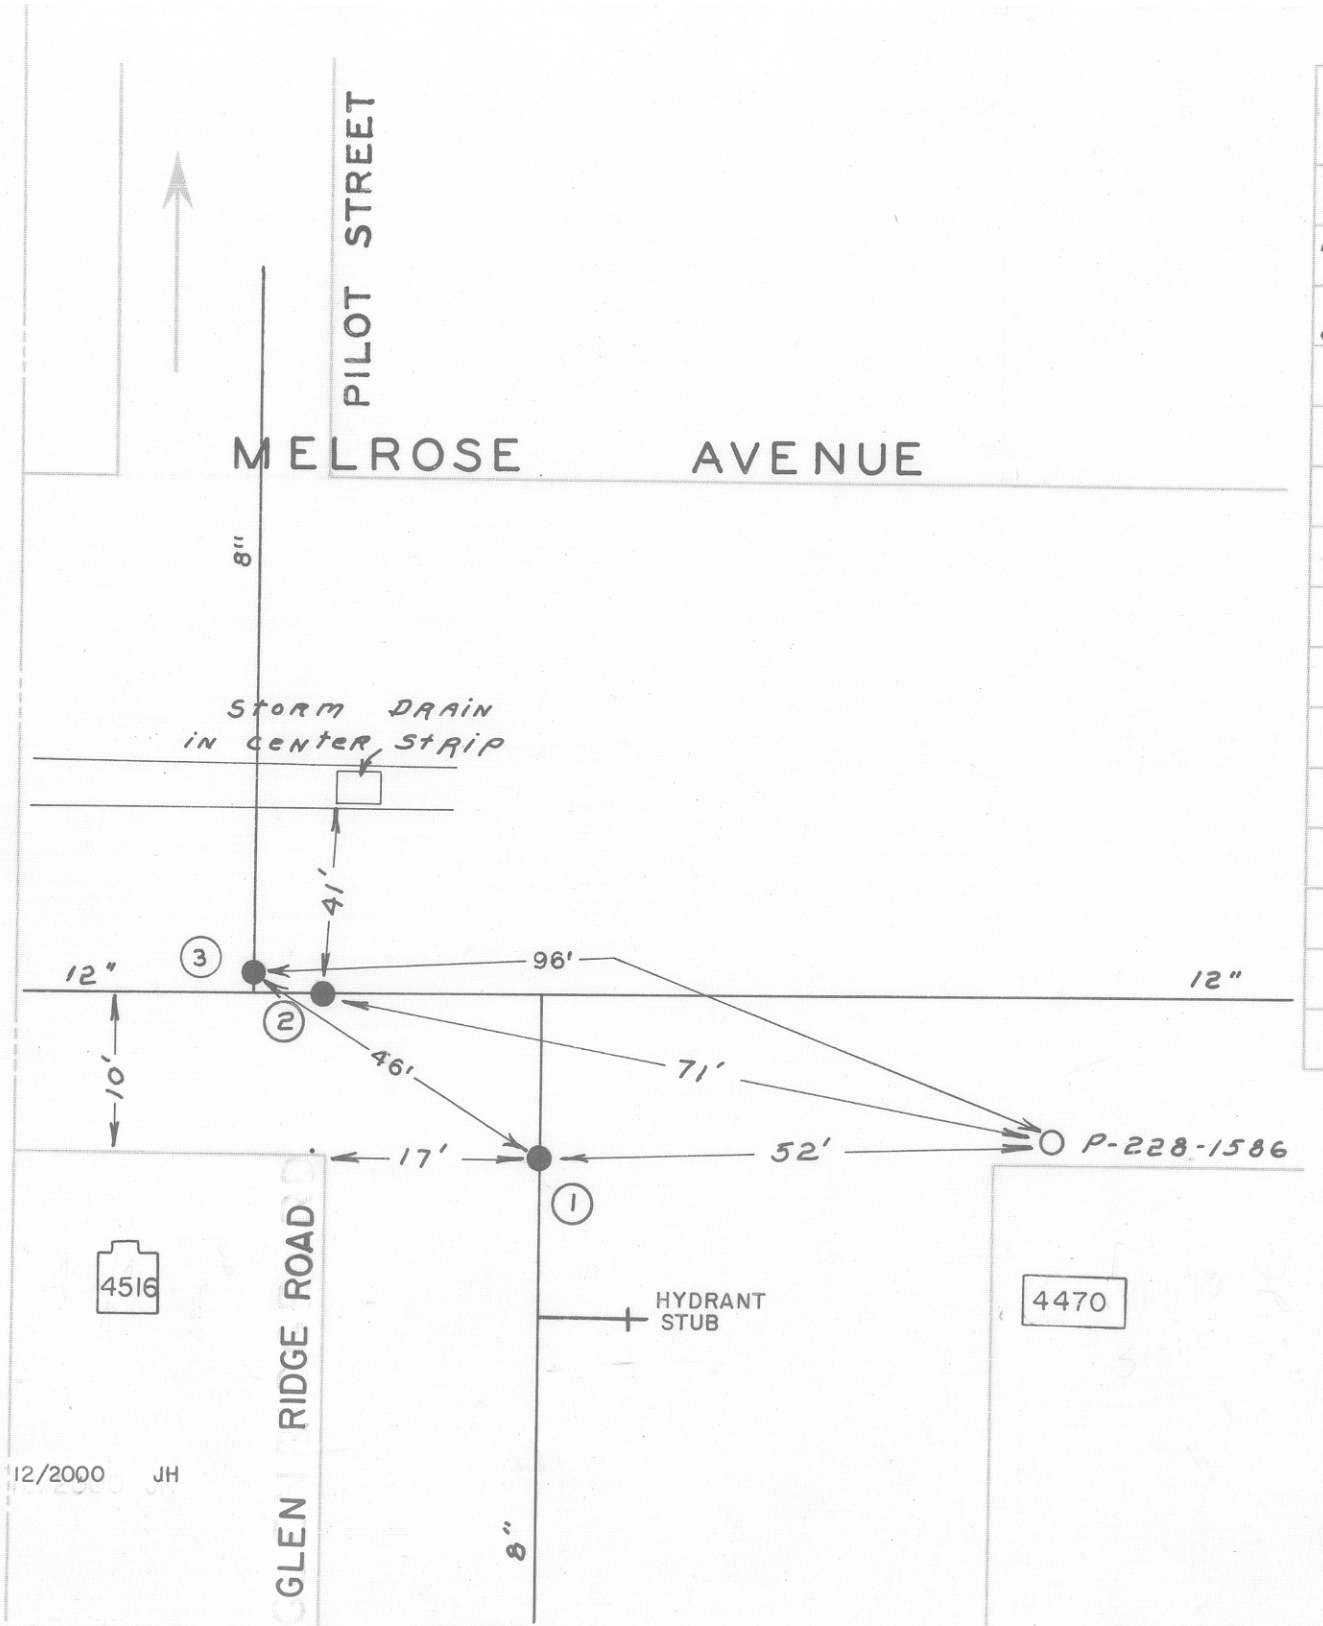

DATE	NO.	SIZE	MAKE	OPEN	TURNS
8-55	1	8"	MUELLER		
'57	2	12"	MUELLER	R	
8-62	3	8"	DARLING	R	27
	1	0	SPL		
	2	0	WPL		
	3	25'W	W.P.L.		

12/2000 JH

CITY OF ROANOKE—WATER DEP'T

VALVE DIAGRAM

GLEN RIDGE RD. &

MELROSE AVE. &

PILOT STREET

SEC. MAP 607, 610 N.W.

DATE PAGE NO.