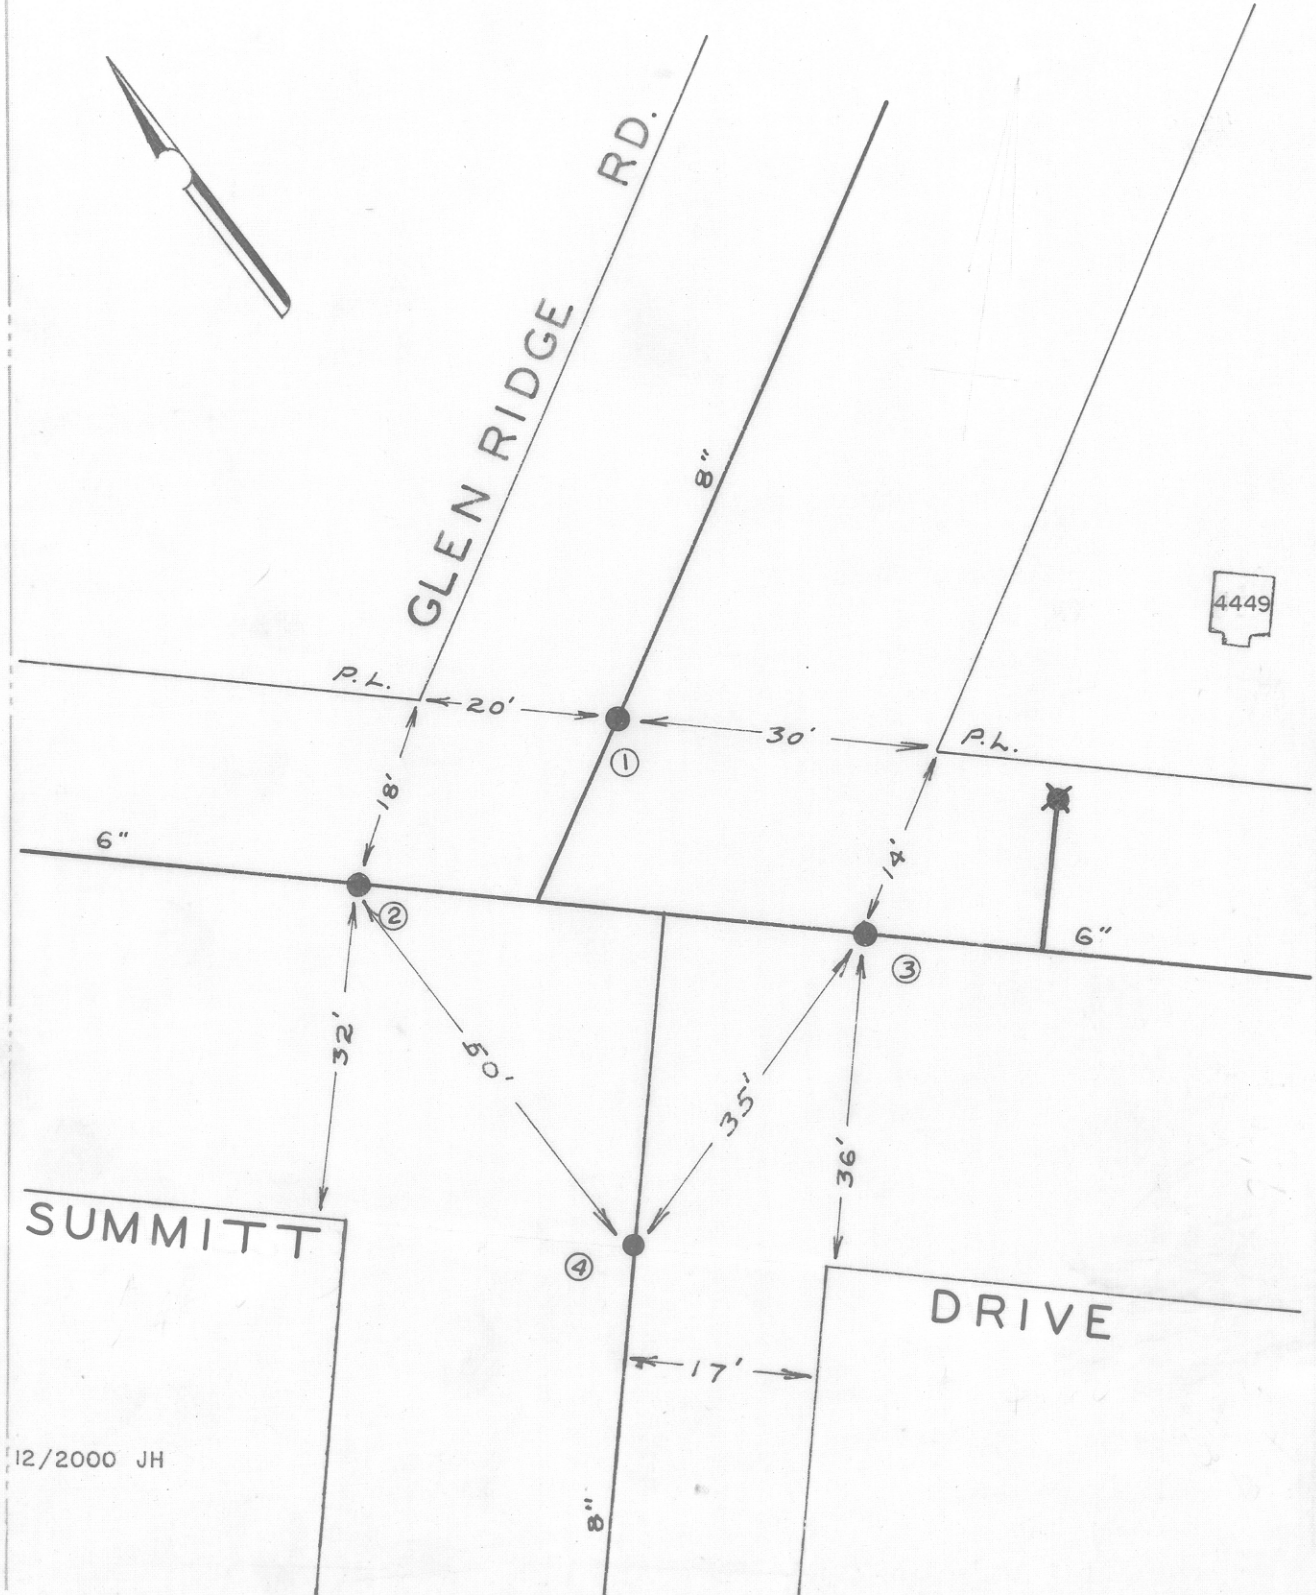

DATE	NO.	SIZE	MAKE	OPEN	TURNS
1955	1	8"	Mueller	R	
1955	2	6"	Mueller	R	
1955	3	6"		R	
1956	4	8"	Mueller	R	
	1	0	NPL		
	2	0	WPL		
	3	0	EPL		
	4	0	SPL		

CITY OF ROANOKE—WATER DEPT.

VALVE DIAGRAM

GLEN RIDGE RD. &

SUMMITT DRIVE N.W.

SEC. MAP 607 N.W.

DATE PAGE NO.

"IMPERIAL" TRACING CLOTH
K & E CO., N. Y.