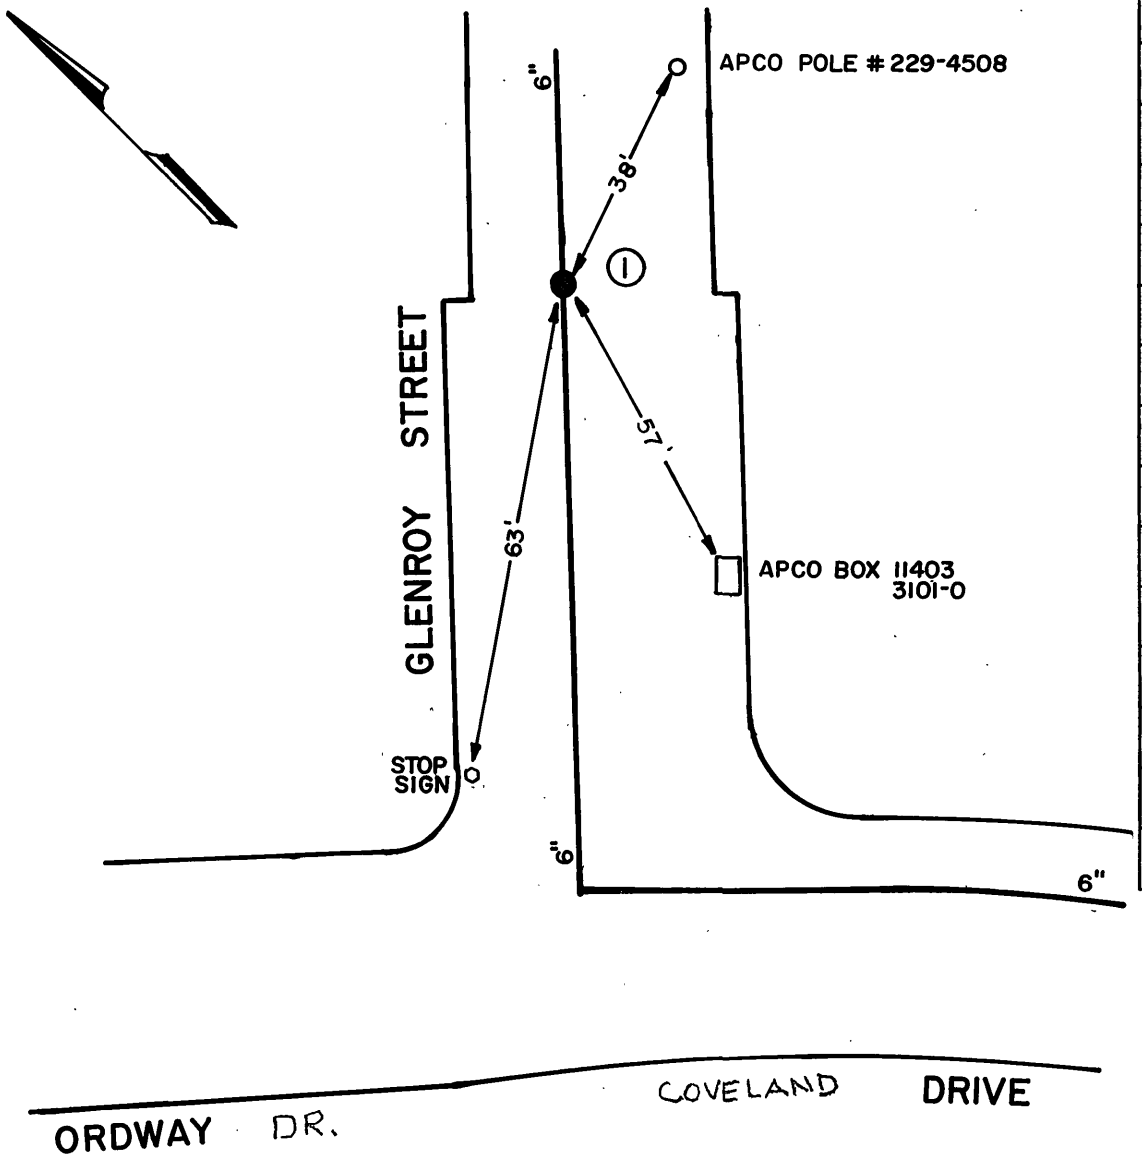

DATE	NO.	SIZE	MAKE	OPEN	TURNS
1980	1	6"			

CITY OF ROANOKE—WATER DEP'T
VALVE DIAGRAM

GLENROY STREET

1800 BLOCK

N.W.

SEC. MAP 248

DATE PAGE NO.

11/90 NP