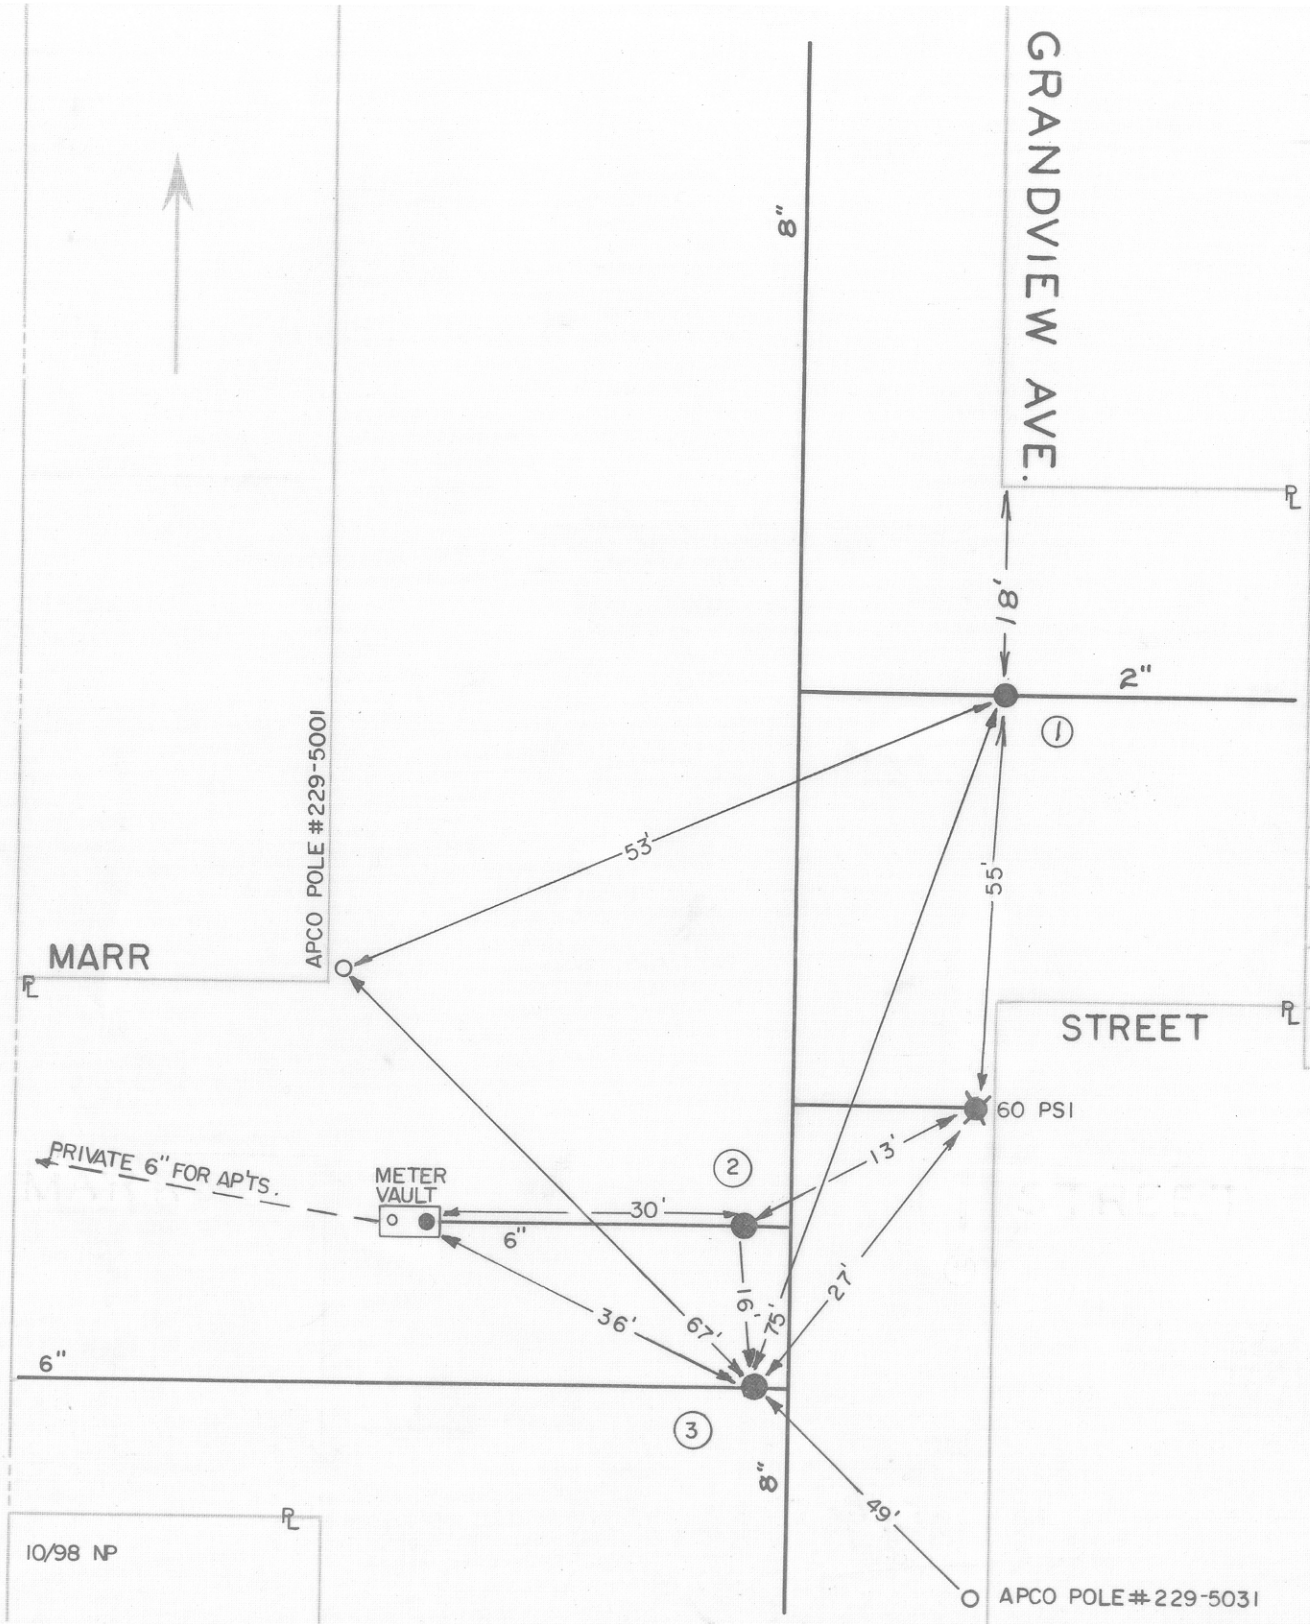


| DATE | NO. | SIZE | MAKE | OPEN | TURNS |
|---|---|---|---|---|---|
| 1955 | 1 | 2" | DARLING | R | 7 |
| | 2 | 6" | | R | 21 |
| 4/1998 | 3 | 6" | MUELLER | R | 21 |
| | | | | | |
| | | | | | |
| | | | | | |
| | | | | | |
| | | | | | |
| | | | | | |
| | | | | | |
| | | | | | |
| | | | | | |
| | 1 | 0 | EPL | | |
| | | | | | |
| | | | | | |

CITY OF ROANOKE—WATER DEP'T

VALVE DIAGRAM

GRANDVIEW AVE. &

MARR STREET N.W.

SEC. MAP 227

DATE PAGE NO.