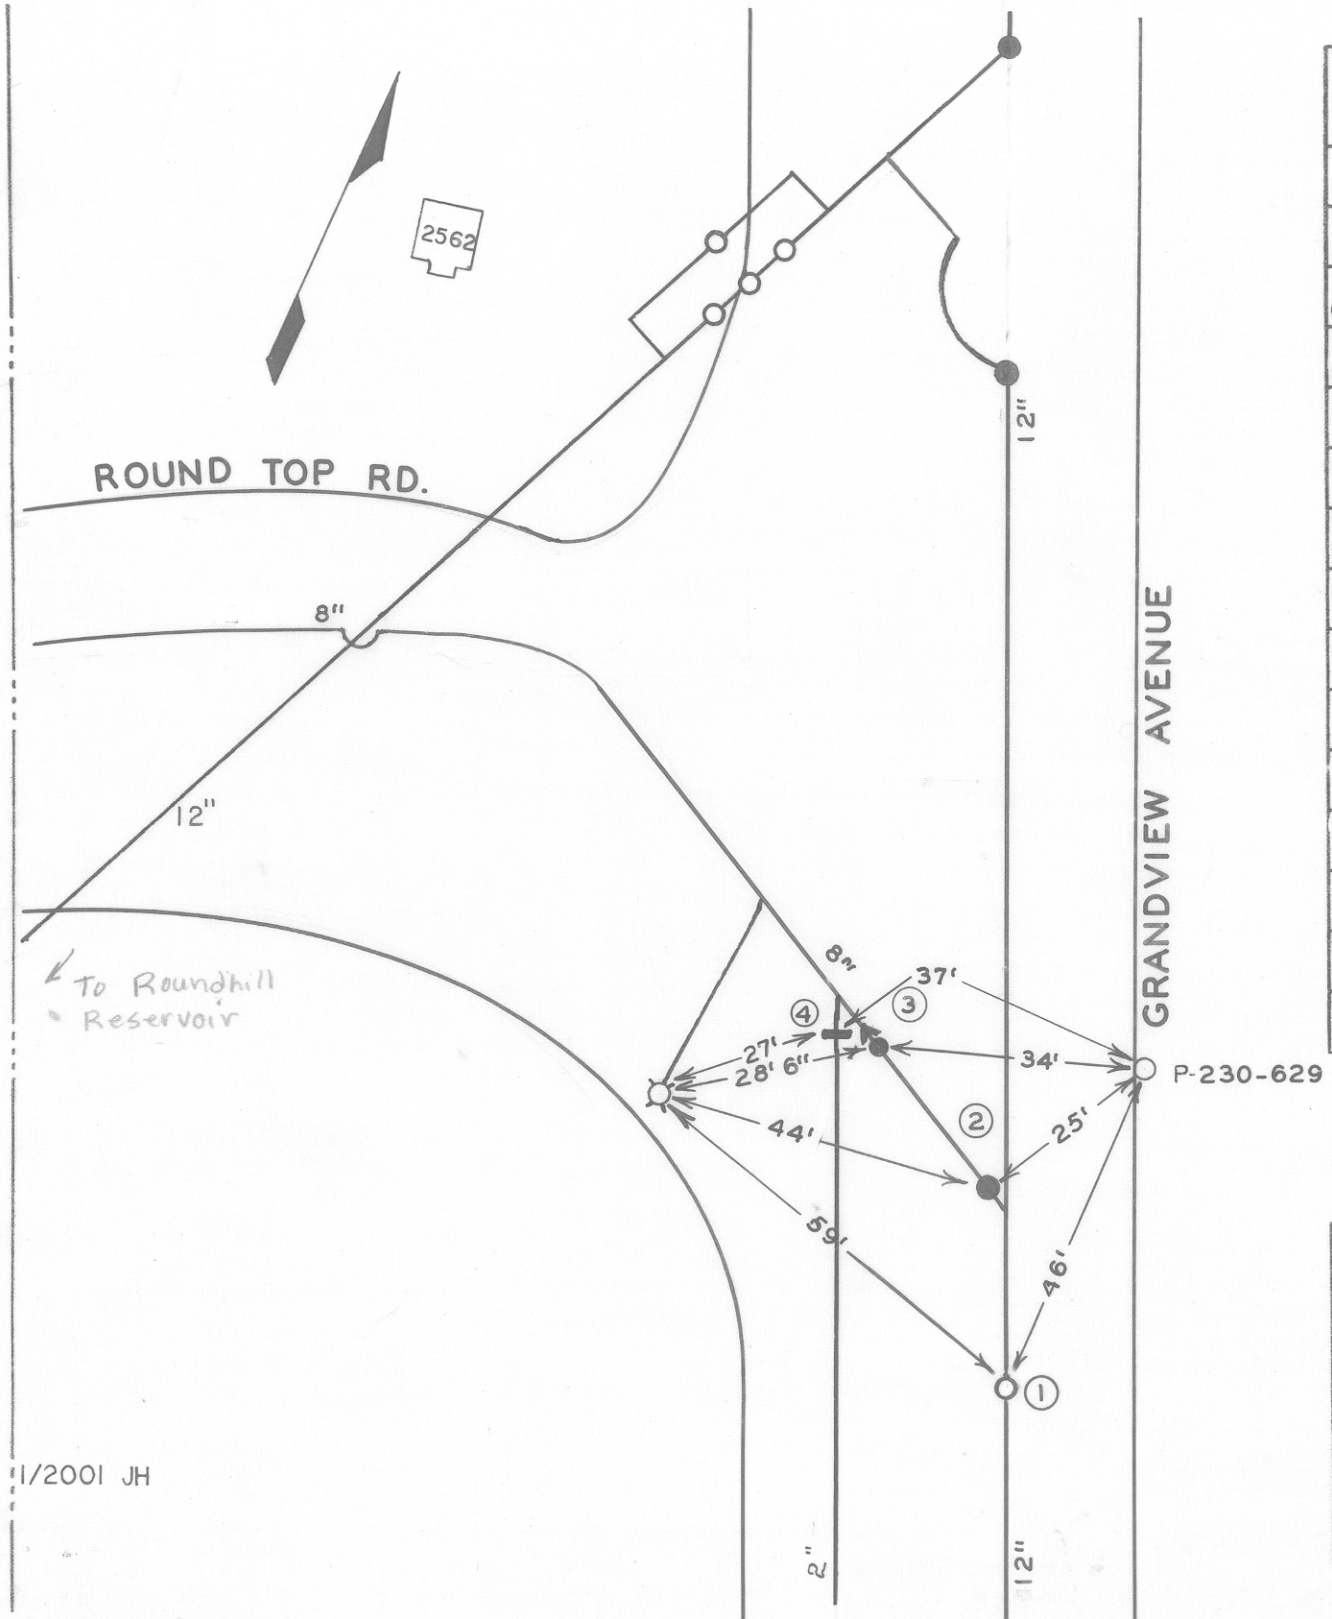

DATE	NO.	SIZE	MAKE	OPEN	TURNS
1953	1		AIR COCK		
1955	2	8"	MUELLER	R	26
6-64	3	6"	CHECK VLV		
10-64	4	2"	DARLING	R	

CITY OF ROANOKE—WATER DEPT.

VALVE DIAGRAM

GRANDVIEW AVENUE &

ROUND TOP ROAD

SEC. MAP 215 N.W.

DATE PAGE NO.