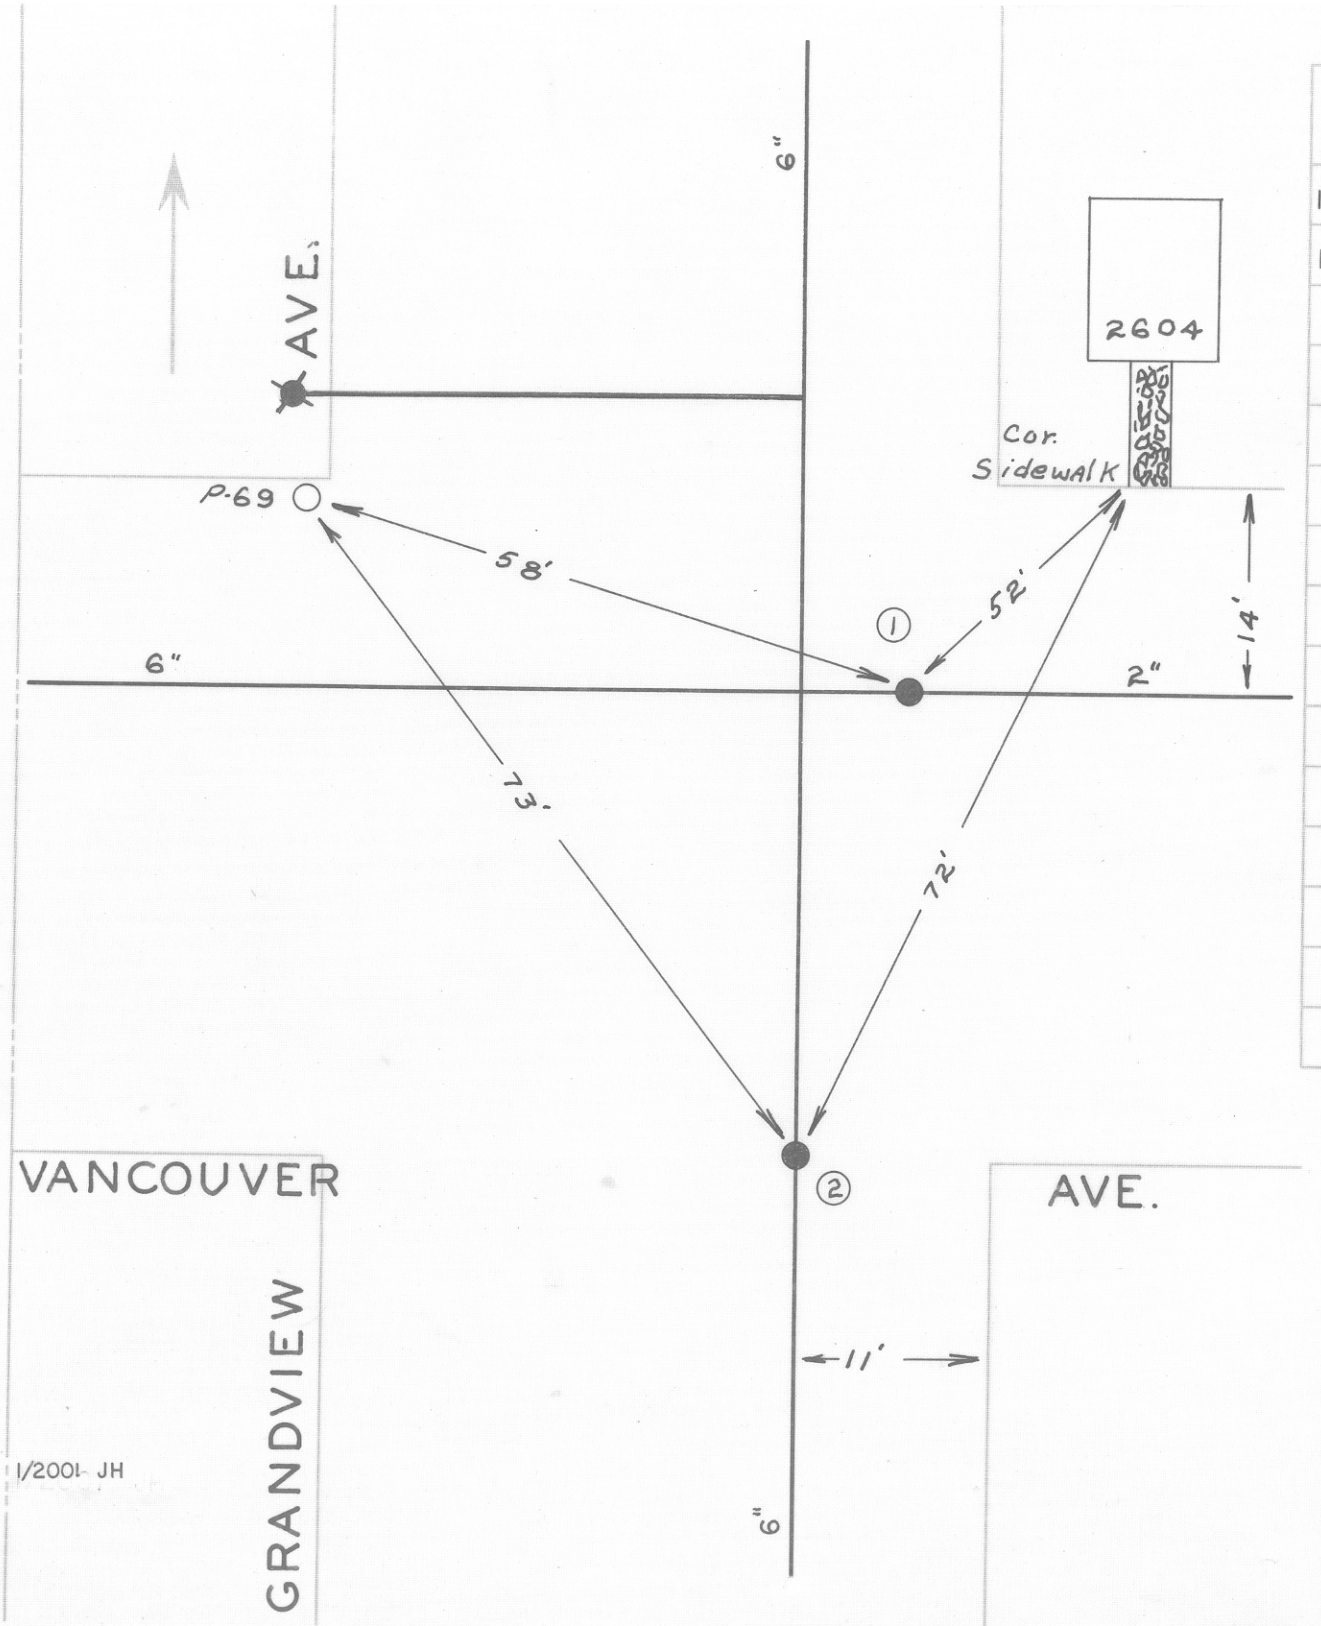

DATE	NO.	SIZE	MAKE	OPEN	TURNS
1951	1	2"			
1951	2	6"			
	1	11'-W	EPL		
	2	0	SPL		

CITY OF ROANOKE—WATER DEP'T

VALVE DIAGRAM

GRANDVIEW AVE. &

VANCOUVER AVE. N.W.

SEC. MAP 226

DATE PAGE NO.